


PAINT TOWNSHIP
 4TH. QTR. LOT 12
 T-10 N; R-5 W
 HOLMES COUNTY, OHIO

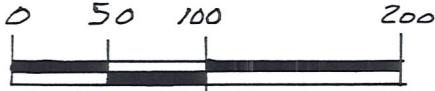

SCALE: 1" = 100'


- IRON PIN FOUND
- STONE FOUND
- 5/8" RE BAR WITH I.D. CAP SET
I.D. CAP MARKED "BAKER 6938"

REFERENCES:

DEED VOL. 223 PAGE 750
 " " 212 " 873
 " " 191 " 820
 " " 199 " 702
 " " 266 " 237

PLAT VOL. 7 PAGE 514
 " " 8 " 739
 " " 10 " 255
 " " 12 " 593

BEARINGS FROM PLAT VOL. 13
 PAGE 8

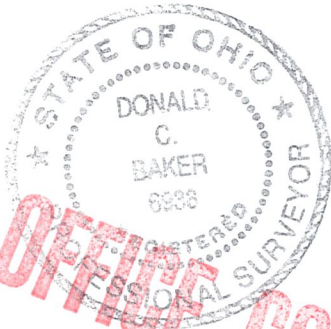


MAP OFFICE COPY

I CERTIFY THIS SURVEY TO BE CORRECT
 TO THE BEST OF MY KNOWLEDGE.

Donald C. Baker
 DONALD C. BAKER P.S. 6938
 5958 T.R. 322
 MILLERSBURG, OHIO 44654
 PH. (330) 674-4788
 NOVEMBER 19, 1996

69596-MLD

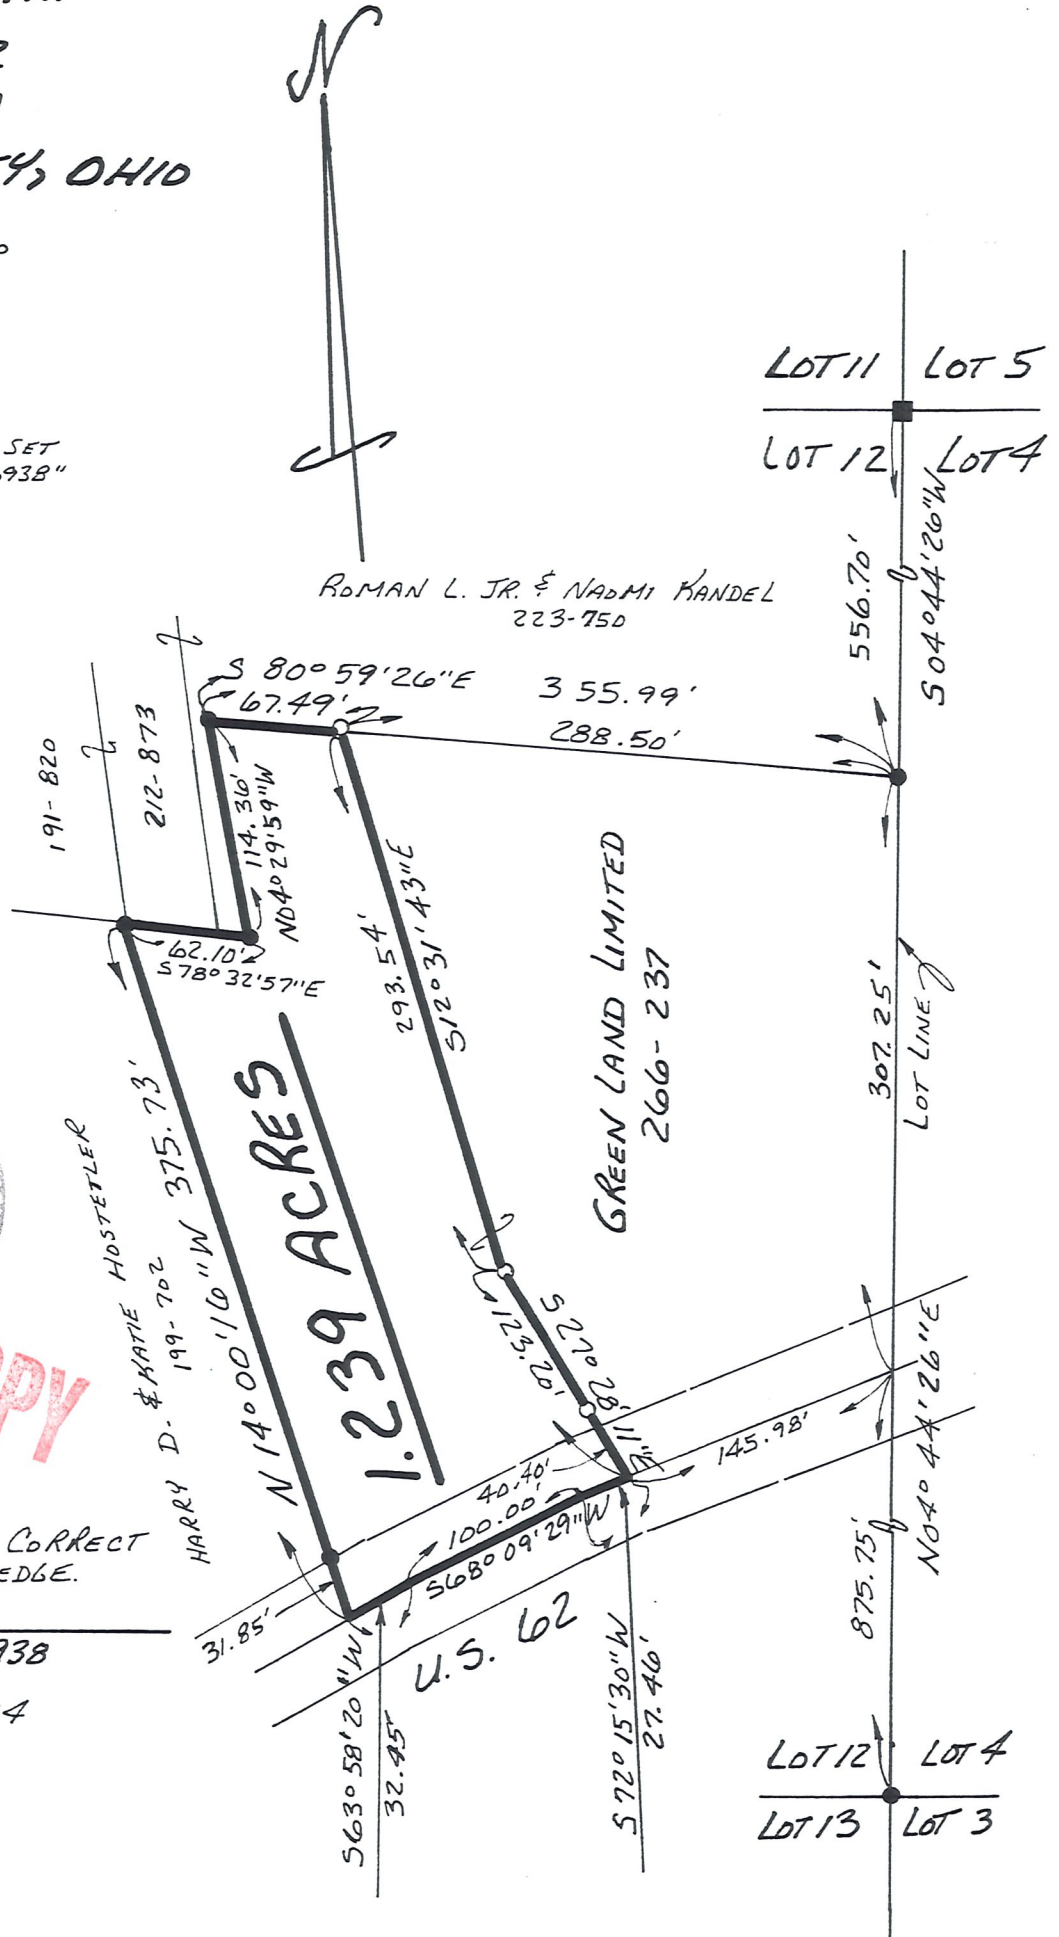

ROMAN L. JR. & NADMI MANDEL
 223-750

GREEN LAND LIMITED
 266-237

1.239 ACRES

HARRY D. & KATIE HOSTETLER
 199-702

U.S. 62