


SCALE: 1"=100'

- 5/8" REBAR FOUND UNLESS OTHERWISE NOTED
- 5/8" REBAR SET WITH I.D. CAP I.D. CAP MARKED "BAKER 6938"


PAINT TOWNSHIP  
 4TH. QTR., LOTS 27 & 28  
 T-10 N; R-5 W  
 HOLMES COUNTY, OHIO

SURVEYED FOR: ROBERT COBLENTZ  
 and DAVID CLEMENS

PLAT TO SHOW THE SETTING OF  
 TWO PROPERTY CORNERS.

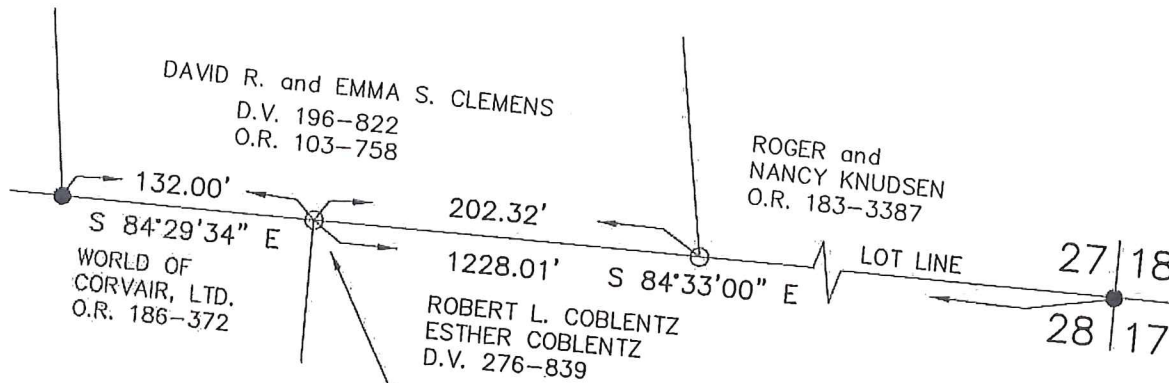

STONE WAS DESTROYED AND  
 RESET CORNER FROM PREVIOUS  
 SURVEY DATA

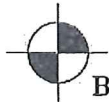

**BAKER SURVEYING, LLC**  
 138 N. CLAY STREET  
 MILLERSBURG, OHIO 44654  
 PH. 330-674-4788  
 FAX 330-674-6027  
 EMAIL: [bakersurveying@gmail.com](mailto:bakersurveying@gmail.com)

REFERENCES

- DEED VOL. 276 PAGE 839
- O.R. VOL. 103 PAGE 758
- PLAT VOL. 7 PAGE 617
- PLAT VOL. 14 PAGE 18
- PLAT VOL. 19 PAGE 907
- PLAT VOL. 19 PAGE 609
- BEARINGS FROM  
 PLAT VOL. 19 PAGE 609



I CERTIFY THIS SURVEY TO BE CORRECT  
 TO THE BEST OF MY KNOWLEDGE.

Aaron L. Gerber  
 AARON L. GERBER P.S. 8379  
 DATE: OCT. 10, 2016  
 ALG\CJG  
 FILE NAME: WORK5\S-538-16

**PRELIMINARY  
 FOR REVIEW ONLY**