
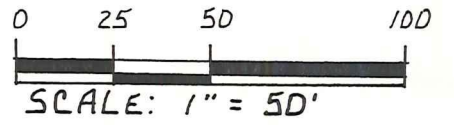


PAINT TOWNSHIP  
 N.W. QTR. FRACTIONAL SEC. 2  
 T-14N; R-11W  
 HOLMES COUNTY, OHIO

SURVEYED FOR LADEAN A. BYER

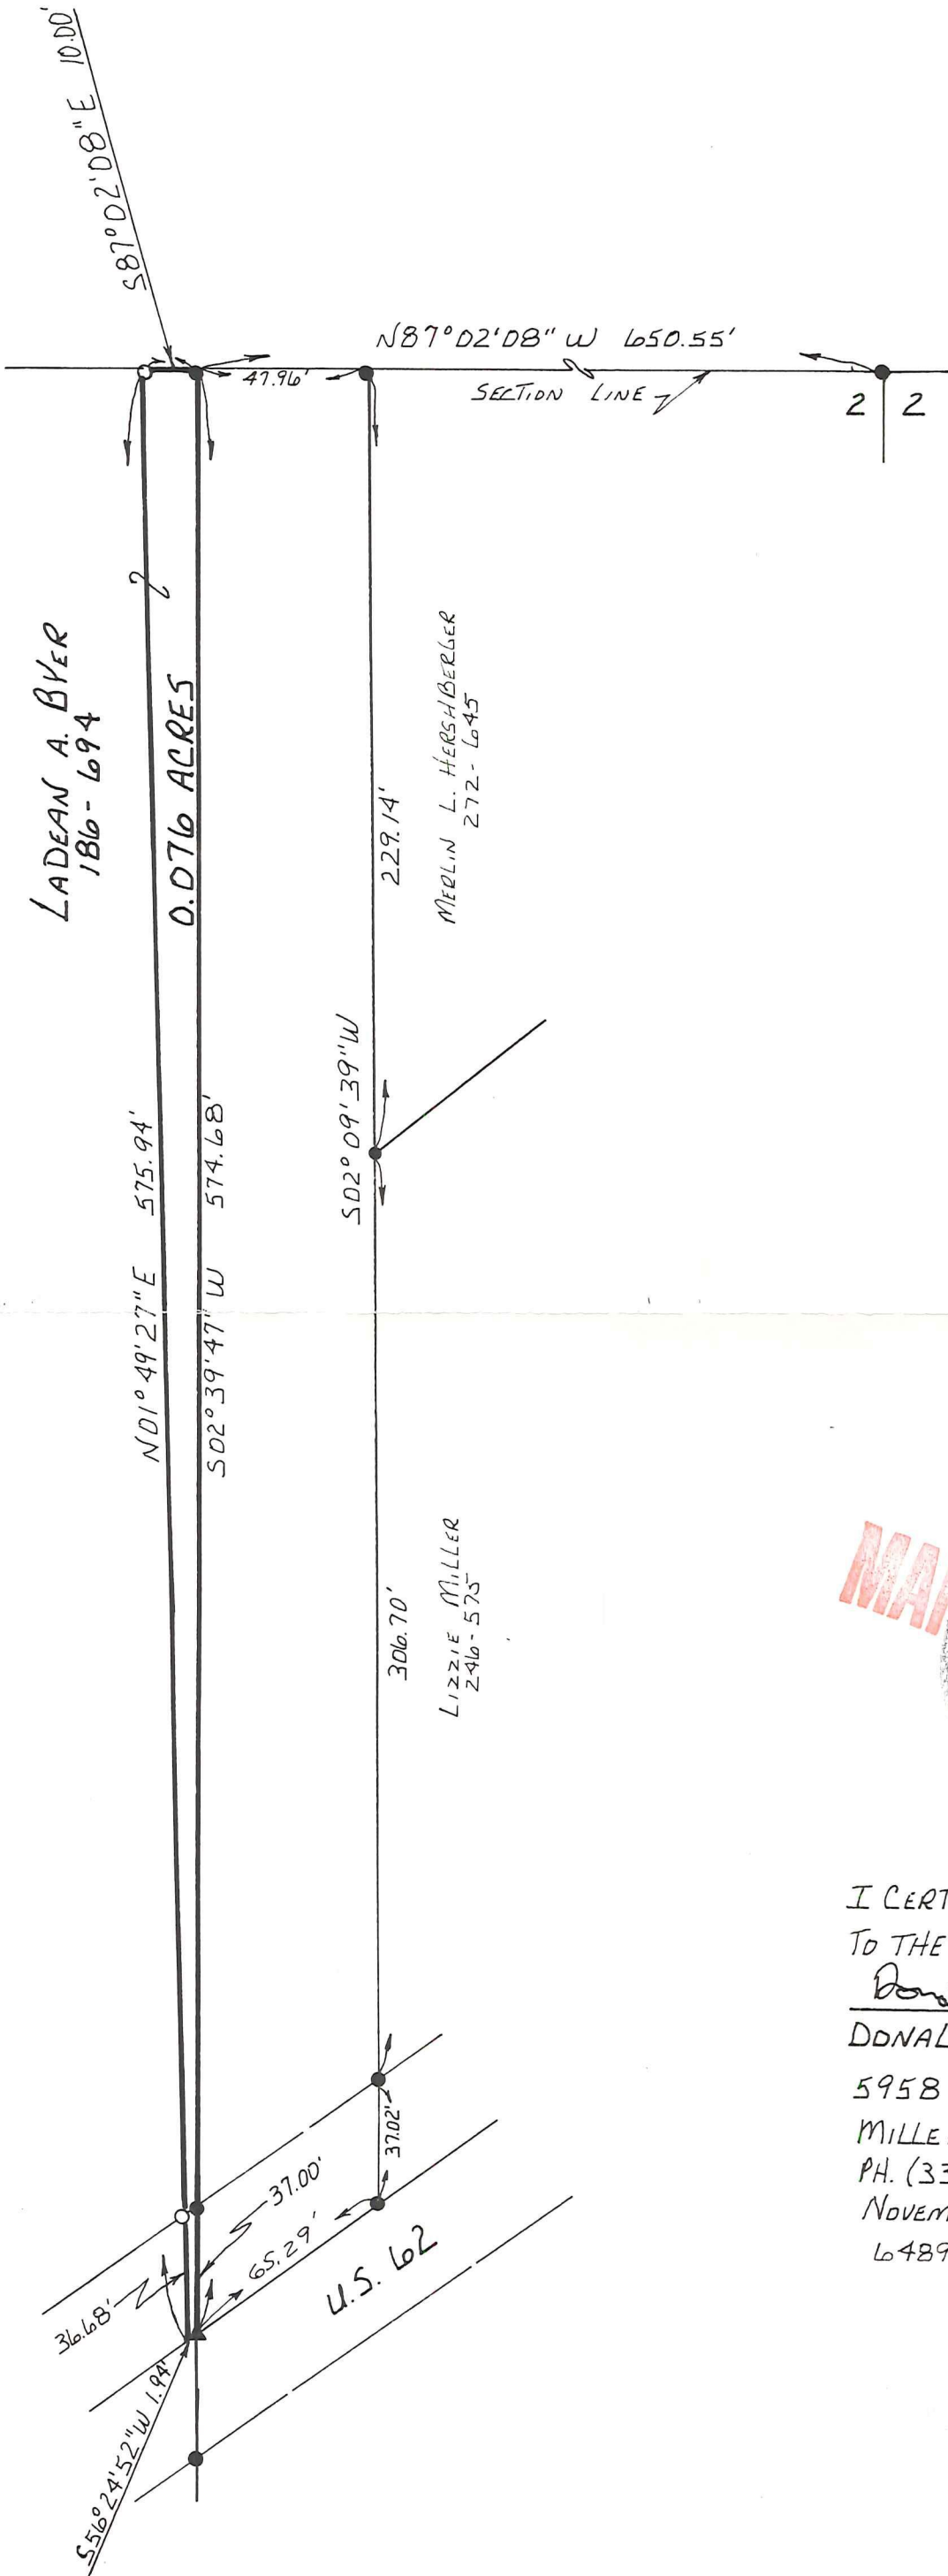

- IRON PIN FOUND
- ▲ R.R. SPIKE FOUND
- 5/8" REBAR WITH ID. CAPSET
- ID. CAP MARKED "BAKER 6938"

REFERENCES:

- DEED Vol. 186 PAGE 694
- DEED Vol. 272 PAGE 645
- DEED Vol. 246 PAGE 575

BEARINGS FROM DEED Vol. 272 PAGE 645



I CERTIFY THIS SURVEY TO BE CORRECT  
 TO THE BEST OF MY KNOWLEDGE.

*Donald C. Baker*

DONALD C. BAKER P.S. 6938

5958 T.R. 322

MILLERSBURG, OHIO 44654

PH. (330) 674-4788

NOVEMBER 7, 1996

64896-SRU