


**PAINT TOWNSHIP  
N.E. QTR. SECTION 2  
T-14N; R-11W  
HOLMES COUNTY, OHIO**

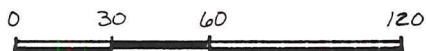


SCALE: 1" = 60'

**REFERENCES:**

DEED VOL. 131	PAGE 353
" "	217 " 179
" "	217 " 177
" "	217 " 175

BEARINGS FROM DEED VOL. 217  
PAGE 177

- IRON PIN FOUND
- △ R.R. SPIKE SET
- 5/8" REBAR WITH I.D. CAP SET
- I.D. CAP MARKED "BAKER 6938"

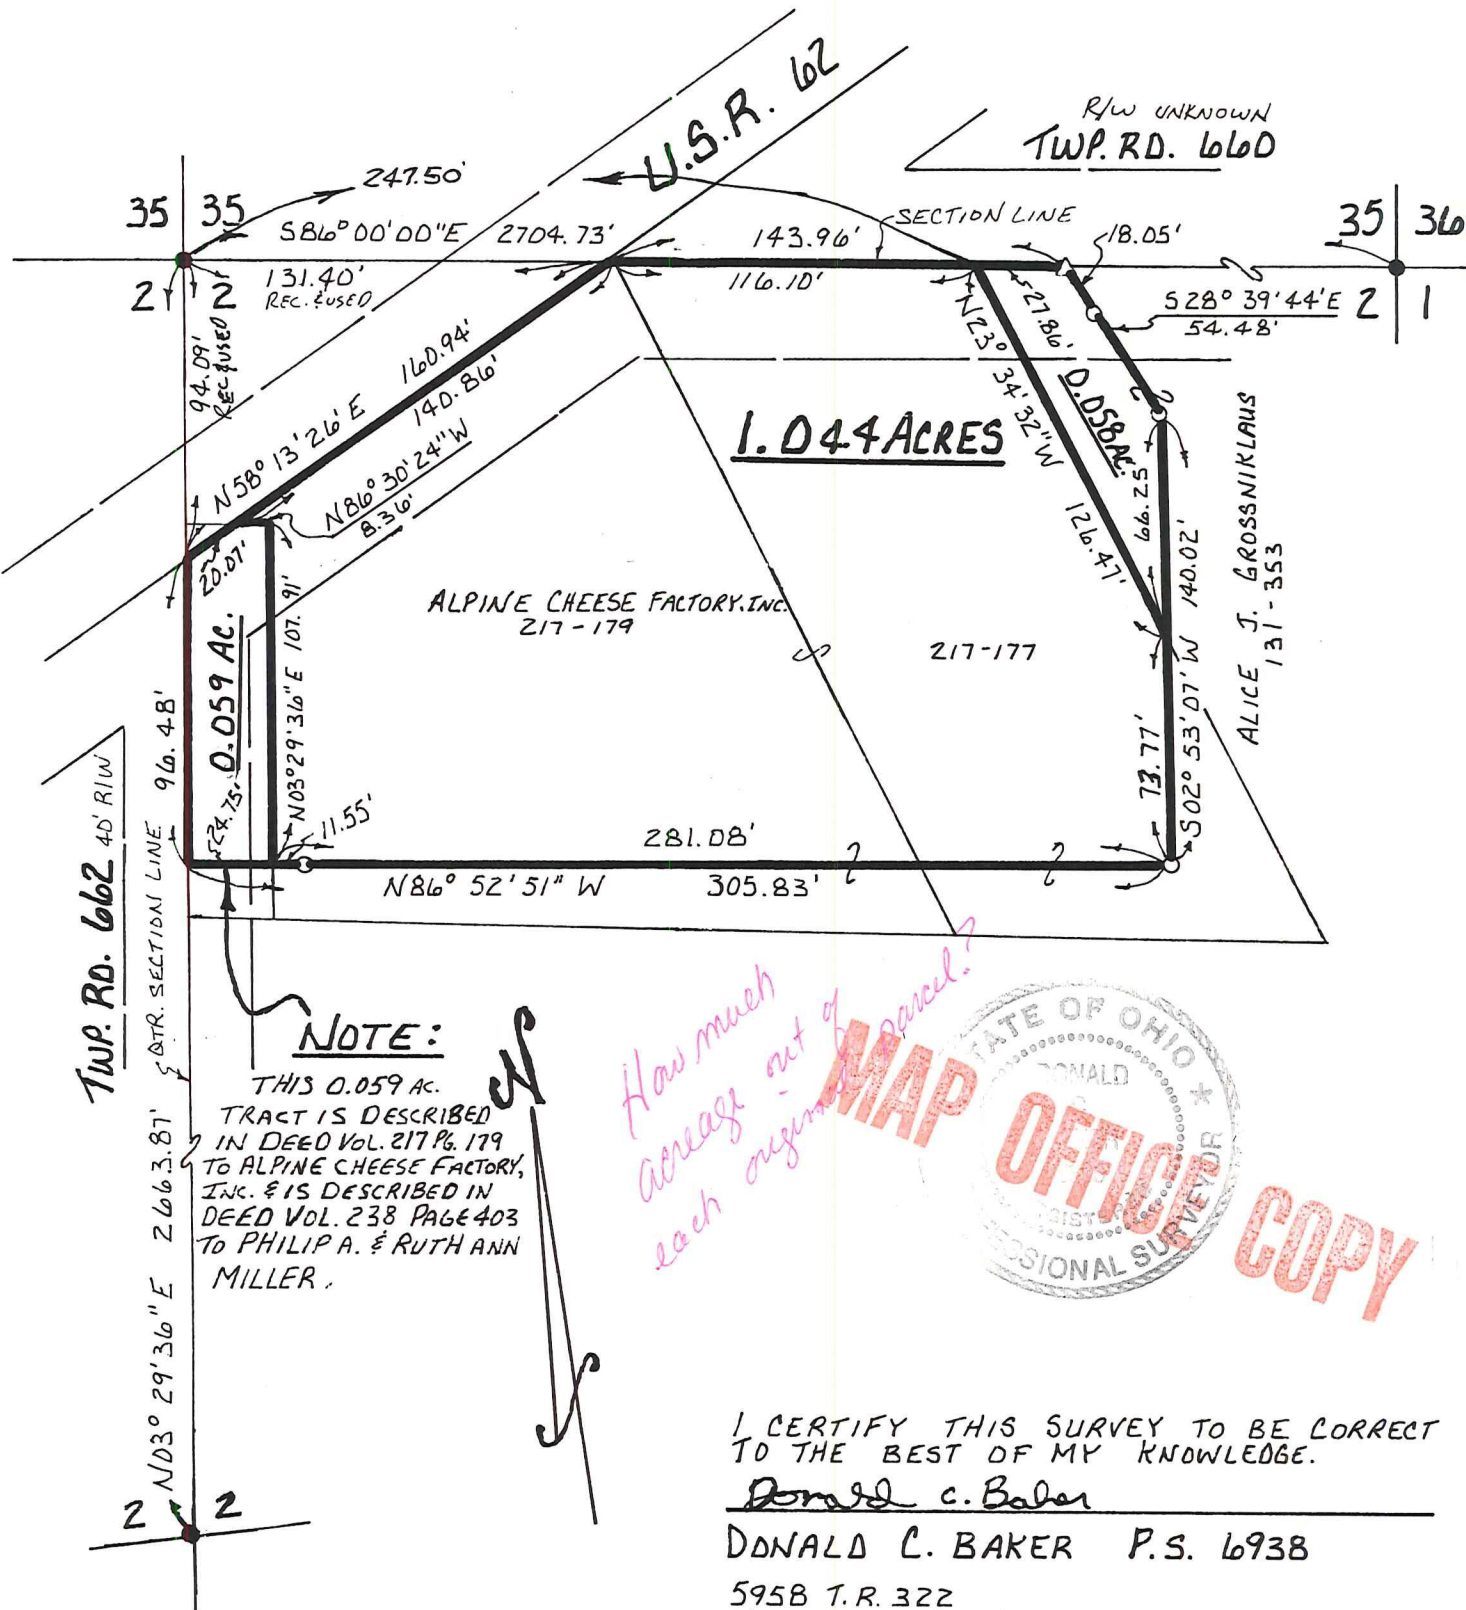

I CERTIFY THIS SURVEY TO BE CORRECT TO THE BEST OF MY KNOWLEDGE.

Donald C. Baker  
DONALD C. BAKER P.S. 6938

595B T.R. 322  
MILLERSBURG, OHIO 44654  
PH: (330) 674-4788  
NOVEMBER 29, 1996

SURVEYED FOR DZIE GROSSNIKLAUS

69896 FJM  
F.C.C. - DC. BAKER