
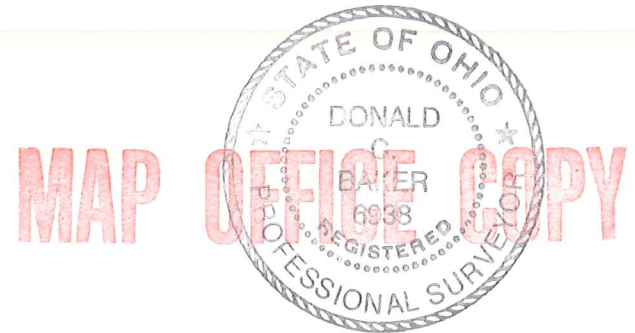


REFERENCES:

DEED VOL. 223 PAGE 875  
" " 281 " 736

PAIN TOWNSHIP  
N.E. QTR. SECTION 2  
T-14N; R-11W  
HOLMES COUNTY, OHIO

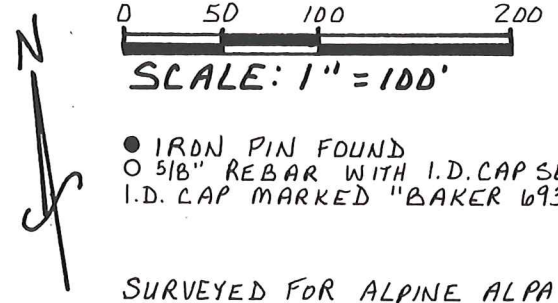

I CERTIFY THIS SURVEY TO BE CORRECT TO THE BEST OF MY KNOWLEDGE.

Donald C. Baker

DONALD C. BAKER P.S. 6938  
138 N. CLAY ST.  
MILLERSBURG, OHIO 44654  
PH: (330) 674-4788

MAY 1, 1998

# 32798-FJM  
F.C.C.-D.C. BAKER