

- A - STONE WITH "+" MARK NW. COR. CHURCH 6.8' NE.
- B - IRON PIN FOUND - SET BY JOHN T. MCCLURE
- C - STONE WITH "+" MARK FOUND BY JOHN T. MCCLURE
- D - AXLE AND END POLE FOUND - SET BY JOHN T. MCCLURE
- E - IRON PIN FOUND - SET BY JOHN T. MCCLURE
- F - RAILROAD SPIKE SET BY GASBARRE - NE COR. CHURCH 41.5' SW - TRANSFORMER POLE 26.55 SE.
- G - RAILROAD SPIKE SET BY GASBARRE - FENCE COR. NW 21.5' - FENCE COR. 21.5' SE
- H - IRON PIPE SET - SW. COR. BASE COTTLEIGH BLASER MONUMENT N.E. 8'
- I - IRON PIPE SET AT FENCE COR.
- J - IRON PIPE SET AT FENCE COR.
- K - IRON PIPE SET - NE. COR. BASE CORNELIUS LOWE MONUMENT SW. 6.8'


TRAVERSE F.G.U.I.A AROUND CEMETERY IS THE PRESENT OCCUPATION OF CEMETERY, BEING DEFINED BY A FENCE BEGINNING AT "A" AND CONTINUING AROUND TO POINT "G" AS INDICATED ON DRAWING.

LINE "U K G" IS THE NORTH LINE OF FRACTIONAL SECTION #3, PAINT TWP, HOLMES COUNTY, OHIO.

IF THE CEMETERY WAS SURVEYED AS DESCRIBED IN DEED DATED 1824, AND RECORDED MARCH 6th 1839 IN VOL 5 Pg. 471 & 472 HOLMES COUNTY RECORDERS OFFICE, IT WOULD LOOK LIKE THE BROKEN LINE TRAVERSE G-L-M-N AS SHOWN ON THIS PLAT.

TRAVERSE "H-I-U-K-" IS THAT PORTION OF PRESENT CEMETERY BEING USED THAT BELONGS TO CORNELIUS LOWE WHO OWNS THE PROPERTY ABUTTING ON THE WEST AND SOUTH. IT CONTAINS 0.085 ACRES.

REF: HOLMES Co. RECORDERS OFFICE
 DEED Vol 56 pg. 98 ; dated 11/6/1890
 Vol 34 pg. 269 dated 10/27/1941
 Vol 5 pg. 471 & 472 dated 3/6/1839

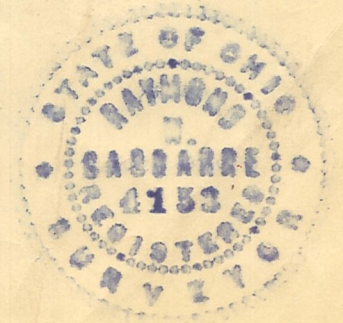

I CERTIFY TO THE BEST OF MY KNOWLEDGE THAT THIS PLAT IS A TRUE RETURN OF FIELD NOTES OF A SURVEY COMPLETED JAN 26-1956 IN FRACTIONAL SECTION 3, PAINT TWP, HOLMES Co. OHIO

Ray W. Gasbarre
 REG. SURVEYOR 4153

