


RECEIVED
 OCT 10 2003
 Hol. Co. Map Office


PAINT TOWNSHIP
 FRACTIONAL SECTION 3
 T- 14 N R- 11 W
 HOLMES COUNTY, OHIO

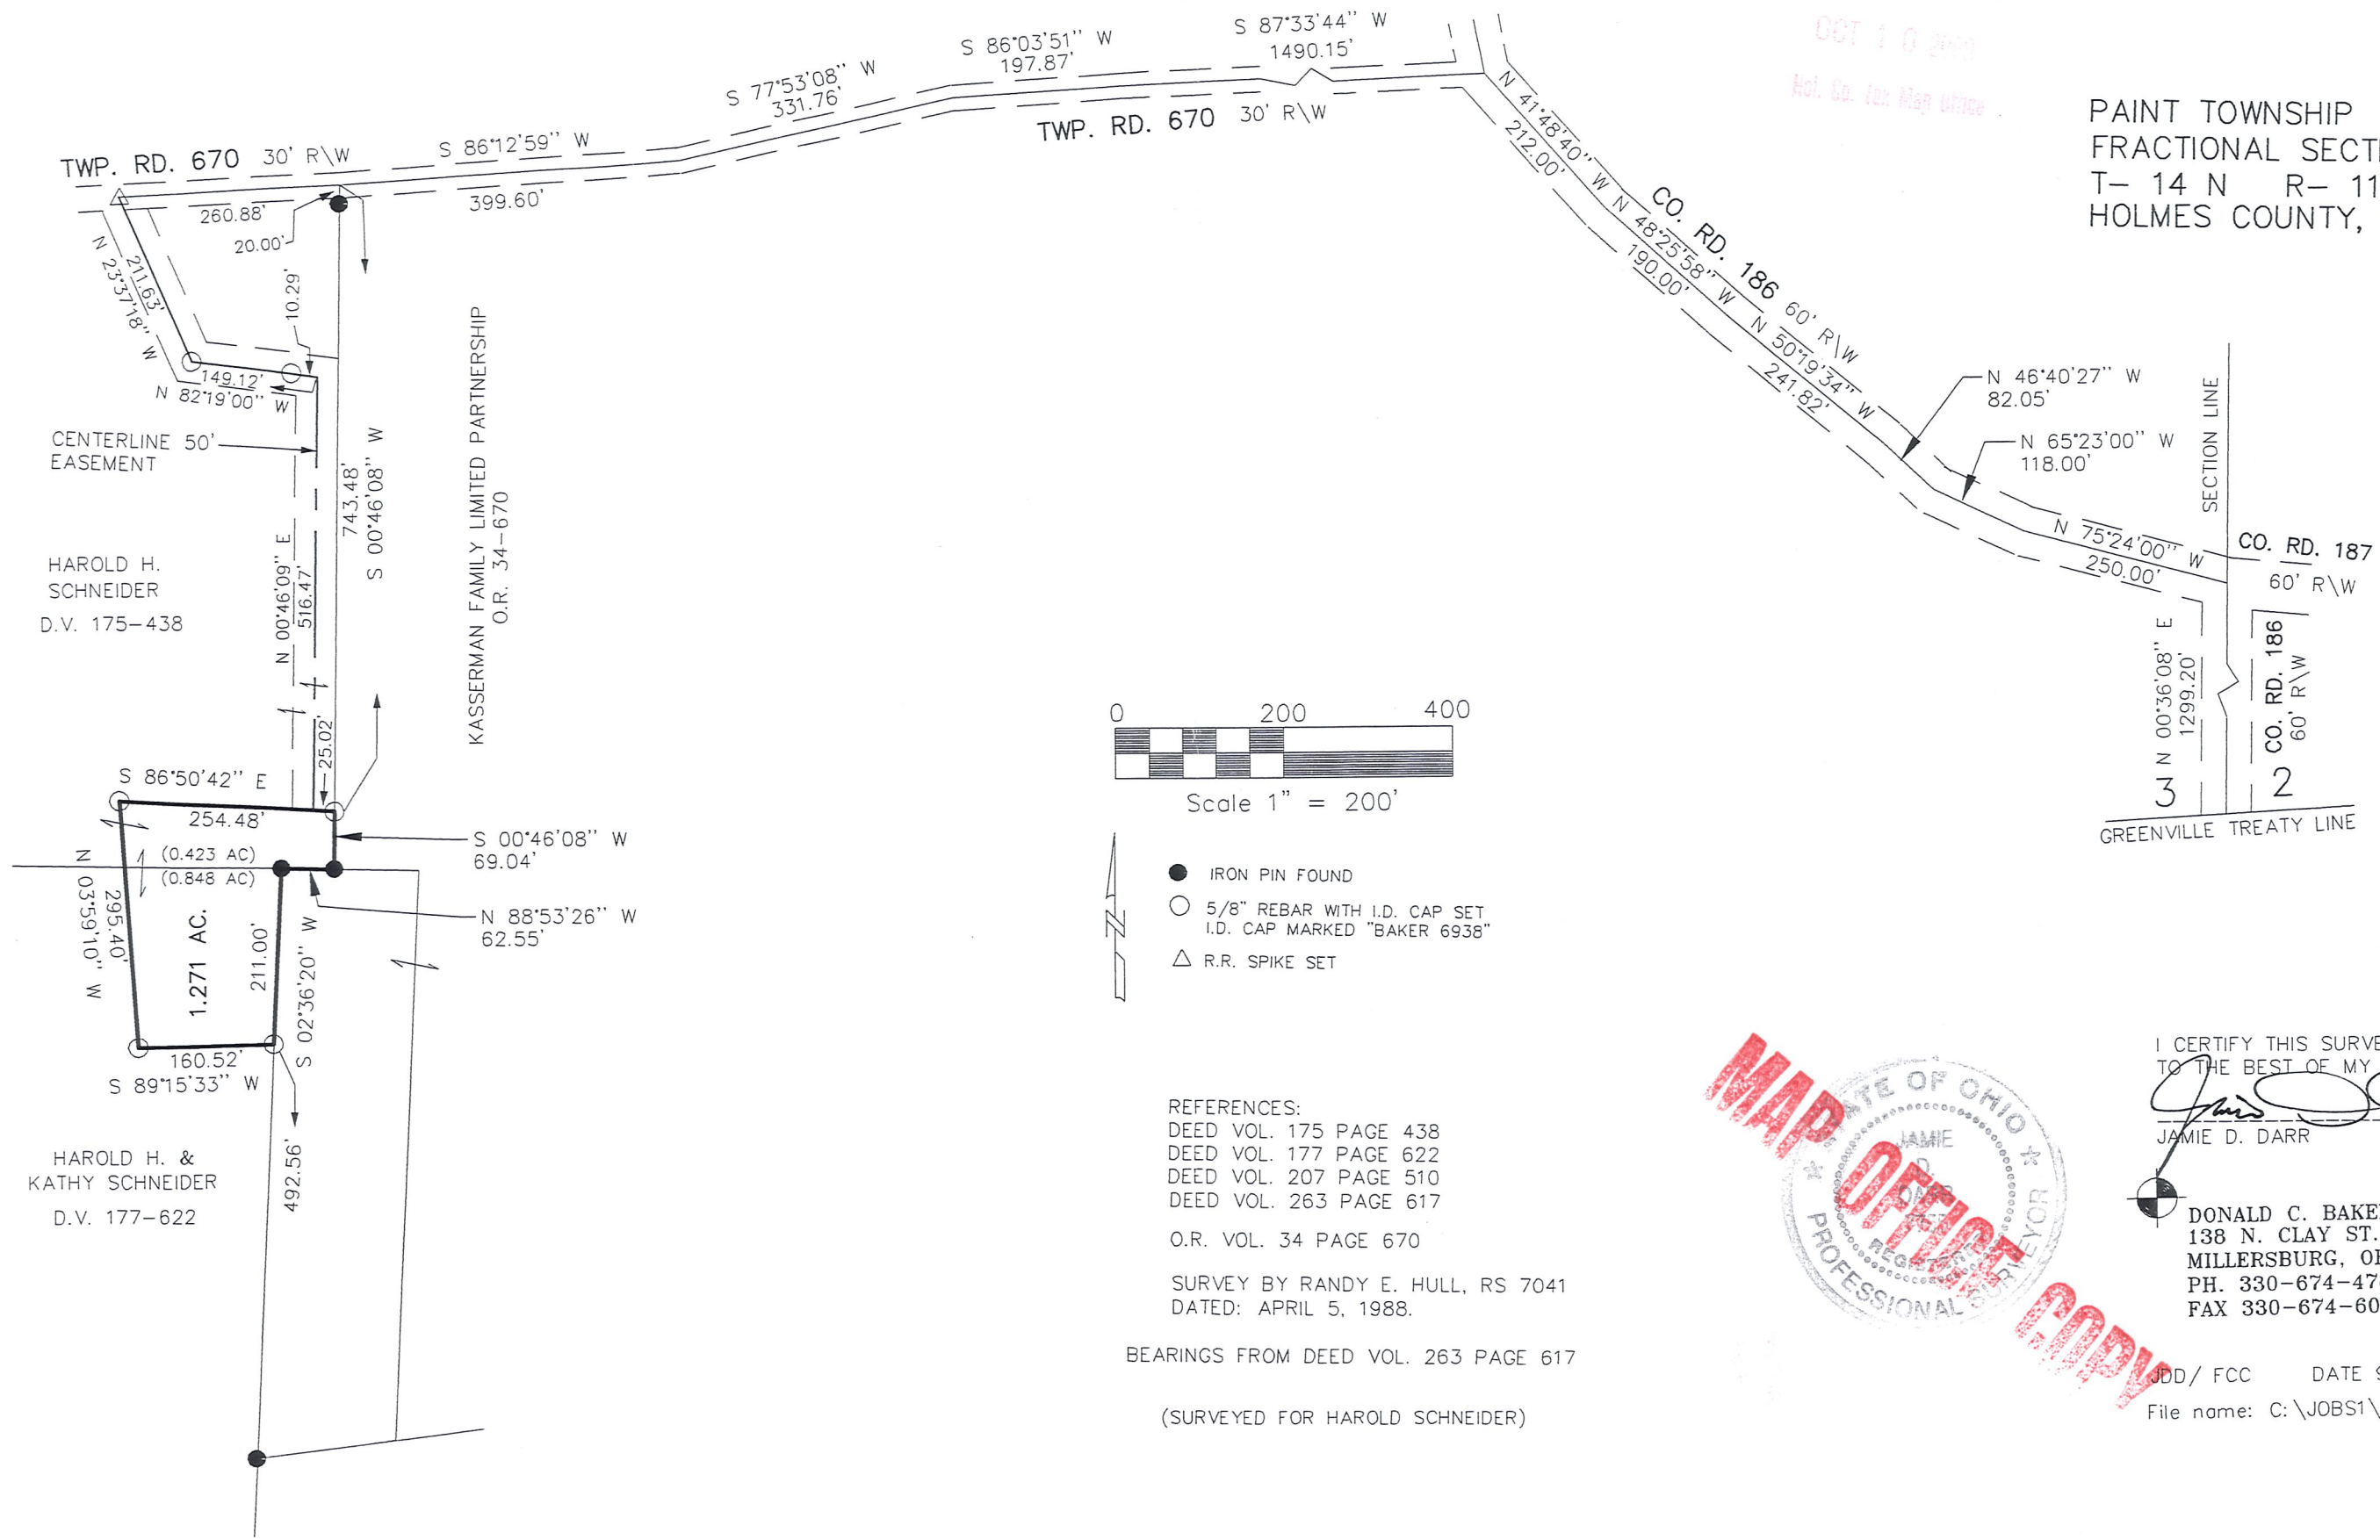

HAROLD H. SCHNEIDER
 D.V. 175-438

KASSERMAN FAMILY LIMITED PARTNERSHIP
 O.R. 34-670

HAROLD H. & KATHY SCHNEIDER
 D.V. 177-622

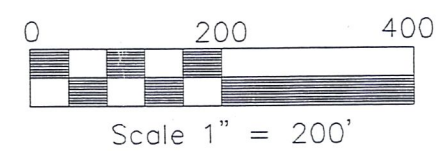

- IRON PIN FOUND
- 5/8" REBAR WITH I.D. CAP SET
I.D. CAP MARKED "BAKER 6938"
- △ R.R. SPIKE SET

REFERENCES:
 DEED VOL. 175 PAGE 438
 DEED VOL. 177 PAGE 622
 DEED VOL. 207 PAGE 510
 DEED VOL. 263 PAGE 617

O.R. VOL. 34 PAGE 670
 SURVEY BY RANDY E. HULL, RS 7041
 DATED: APRIL 5, 1988.

BEARINGS FROM DEED VOL. 263 PAGE 617
 (SURVEYED FOR HAROLD SCHNEIDER)



I CERTIFY THIS SURVEY TO BE CORRECT TO THE BEST OF MY KNOWLEDGE.
Jamie D. Darr
 JAMIE D. DARR P.S. 7755

DONALD C. BAKER SURVEYING
 138 N. CLAY ST.
 MILLERSBURG, OHIO 44654
 PH. 330-674-4788
 FAX 330-674-6027

JDD/ FCC DATE 9-29-00
 File name: C:\JOBS1\S-527-00