



PAINT TOWNSHIP
 S.W. QTR. SECTION 25
 T-15 N R-11 W
 HOLMES COUNTY, OHIO

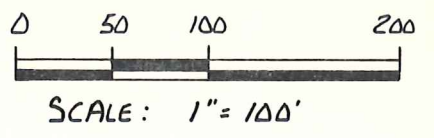


- STONE WITH "X" FOUND
- IRON PIN FOUND
- 5/8" RE BAR WITH ID CAP SET
I.D. CAP MARKED "BAKER 6938"

BEARINGS ASSUMED

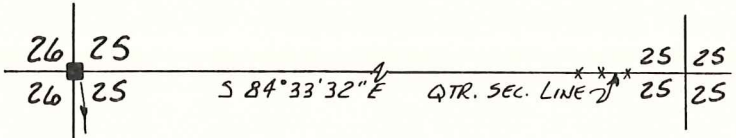


LED H. TRESSSELL
 DEED VOL. 161 PAGE 585

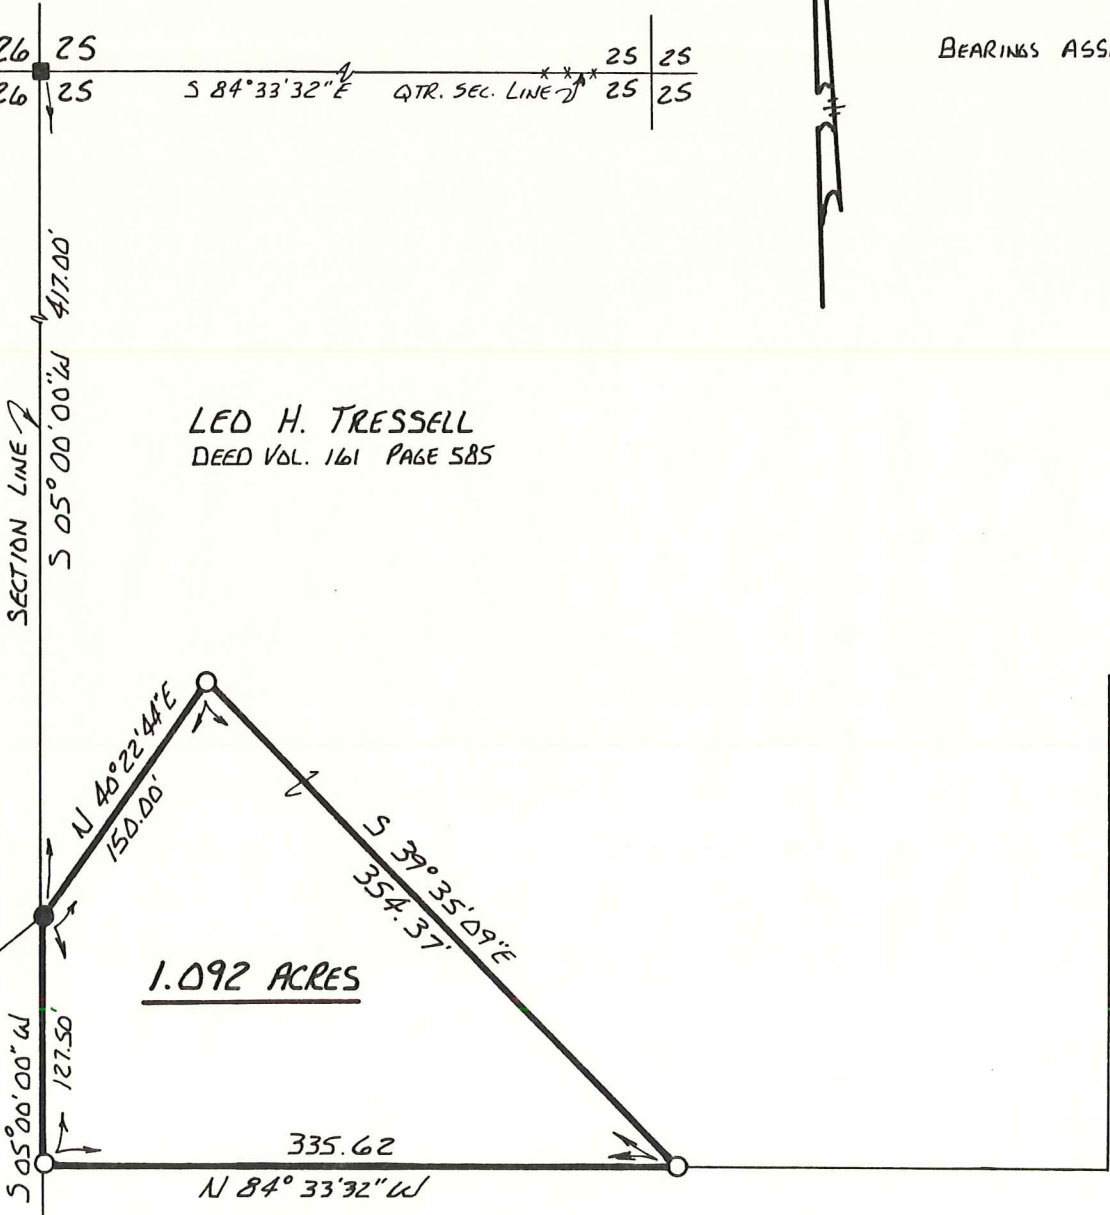

ELI R. & KATIE COBLENTZ
 209-91

MAP OF OHIO COPY

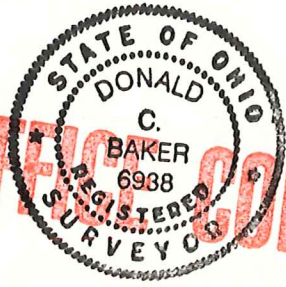

I CERTIFY THIS SURVEY TO BE CORRECT
 TO THE BEST OF MY KNOWLEDGE.

Donald C. Baker
 DONALD C. BAKER P.S. 6938
 4321 T.R. 252
 GLENMONT, OH.

JULY 19, 1989