


CURVE DATA

CURVE "A"	CURVE "B"	CURVE "C"
Δ- 00°40'23"	Δ- 04°00'18"	Δ- 02°02'35"
R- 1432.50'	R- 1432.50'	R- 1432.50'
T- 9.60'	T- 50.09'	T- 25.54'
ARC- 19.33'	ARC- 100.13'	ARC- 51.08'
CH- 19.33'	CH- 100.11'	CH- 51.07'
BRG- N77°42'29"E	BRG- S75°19'09"W	BRG- S66°13'48"W

PAINT TOWNSHIP
 S.E. PTR. SECTION 25
 T-15N ; R-11W
 HOLMES COUNTY, OHIO

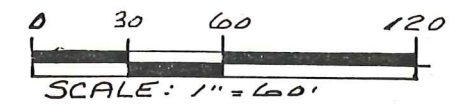


- STONE FOUND
- P.K. NAIL FOUND
- IRON PIN FOUND
- △ R.R. SPIKE SET
- 5/8" RE BAR WITH I.D. CAP SET
I.D. CAP MARKED "BAKER 6938"

REFERENCES:

- PLAT VOL. 5 PAGE 12
- PLAT VOL. 7 PAGE 581
- PLAT VOL. 7 PAGE 204
- PLAT VOL. 8 PAGE 587
- DEED VOL. 128 PAGE 276
- DEED VOL. 132 PAGE 514

(NOTE: PROPERTY LINE FOLLOWS
 CENTERLINE OF OLD ROAD.)

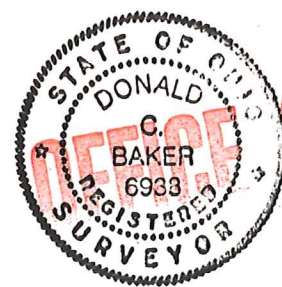

MAP COPY

I CERTIFY THIS SURVEY TO BE CORRECT
 TO THE BEST OF MY KNOWLEDGE.

Donald C. Baker
 DONALD C. BAKER P. S. 6938
 5958 T. R. 322
 MILLERSBURG OHIO 44654
 PH. (216) 674-4788

FEBRUARY 6, 1993

6193-MLS