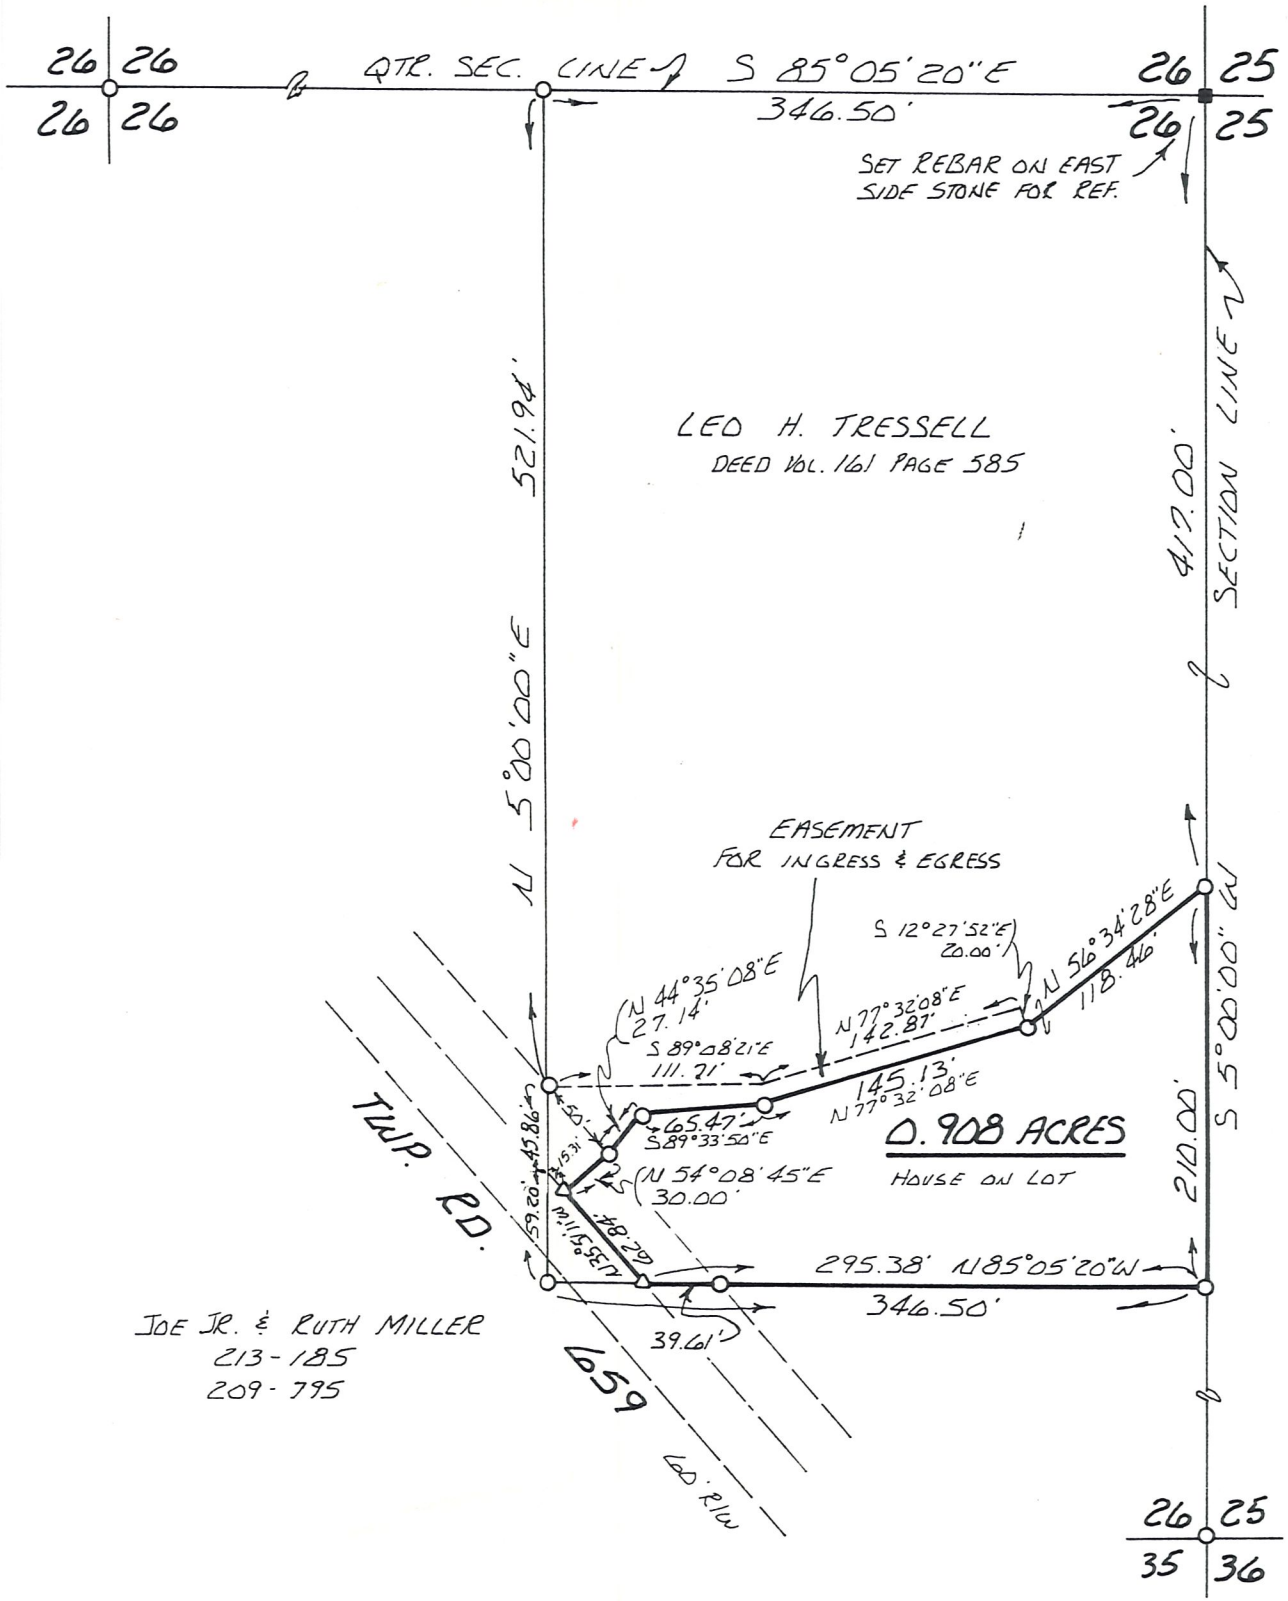

PAINT TOWNSHIP
S.E. QTR. SECTION 26
T-15N R-11W
HOLMES COUNTY, OHIO

0 50 100 200

SCALE: 1" = 100'

- ■ STONE WITH "X" FOUND
- △ 5/8" REBAR SET
- ○ 5/8" REBAR WITH I.D. CAP SET
  I.D. CAP MARKED "BAKER 6938"

BEARINGS ASSUMED

MAP OFFICE COPY

STATE OF OHIO
DONALD C. BAKER
6938
REGISTERED SURVEYOR

I CERTIFY THIS SURVEY TO BE CORRECT TO THE BEST OF MY KNOWLEDGE.

Donald C Baker

DONALD C. BAKER P.S. 6938
4321 TR 252
GLENMONT, OH.

OCT. 6, 1988