

- STONE FOUND
- IRON PIN FOUND
- 5/8" IRON BAR WITH I.D. CAP SET  
I.D. CAP MARKED "BAKER 6938"

PAINT TOWNSHIP  
 N.E. QTR. SECTION 26  
 T-15 N; R-11W  
 HOLMES COUNTY, OHIO  
 (SURVEYED FOR: FREEMAN YODER)

REFERENCES:

DEED VOL. 241 PAGE 220  
 DEED VOL. 244 PAGE 302

BEARINGS FROM PLAT VOL. 12 PAGE 273



I CERTIFY THIS SURVEY TO BE CORRECT  
 TO THE BEST OF MY KNOWLEDGE.

*Jamie D. Darr*

JAMIE D. DARR P.S. 7755

DONALD C. BAKER SURVEYOR  
 138 N. CLAY ST.


MILLERSBURG, OHIO 44654

PH. (330) 674-4788

NOVEMBER 18, 1999

#68899 - M.L. DAVIS

F.C.C. - J.D. DARR

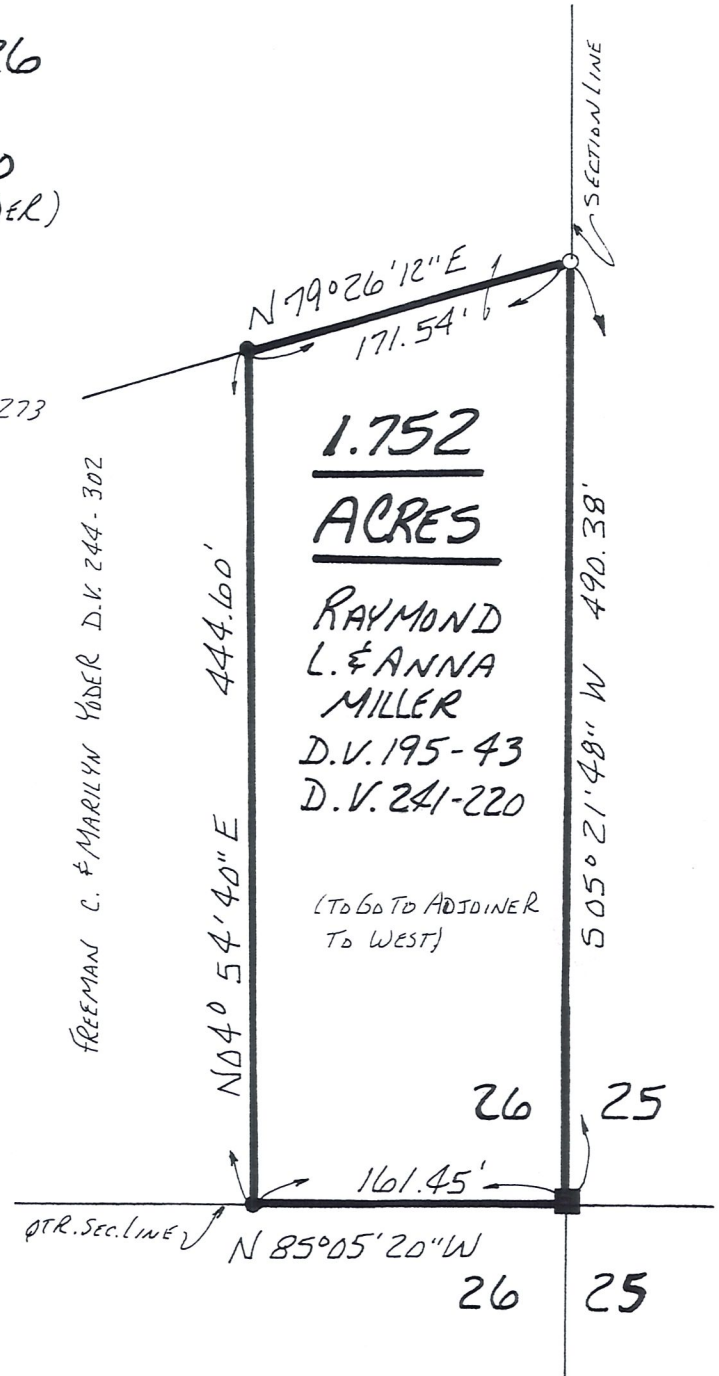

RECEIVED  
 NOV 19 1999  
 Hol. Co. Tax Map Office