WAYNE COUNTY
PAINT TOWNSHIP
S.W. QUARTER Sec 21
T-15 R-11

89040'
36 48
12588

17960
12628
5332

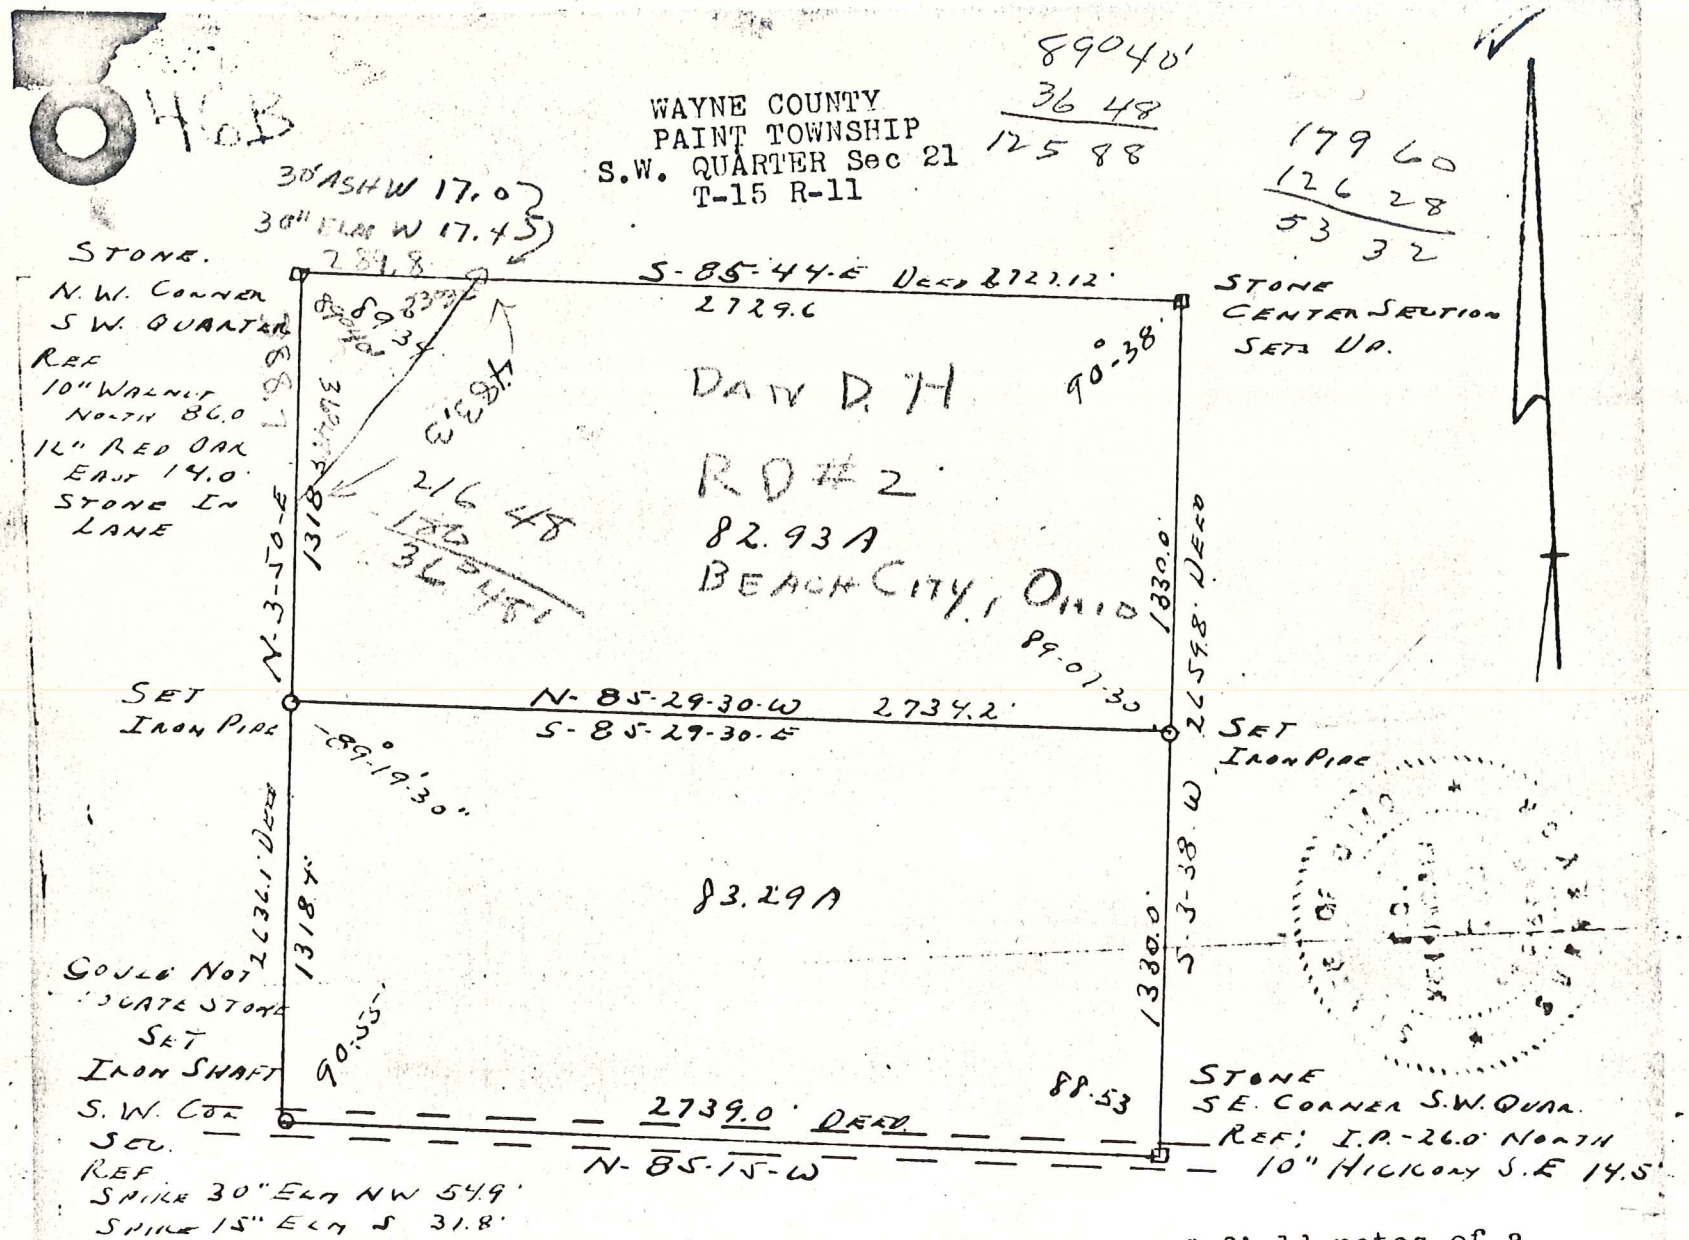

I certify that this plat made from a true return of field notes of a survey made March 5th 1951 for the owner Levi Hershberger to divide the south west quarter of section 21, Paint Twp., Wayne County, State of Ohio

Scale 1" 600.0'

Signed F.D. Krichbaum

F.D. Krichbaum Registered Surveyor 1799
State of Ohio

N 546

MAP OFFICE COPY