


PRAIRIE TOWNSHIP
4TH. QTR., LOT 2
T-10 N; R-7 W
HOLMES COUNTY, OHIO

SURVEYED FOR: MILTON R. TROYER


REFERENCES

DEED VOL. 240 PAGE 198
O.R. VOL. 103 PAGE 819
BEARINGS ASSUMED

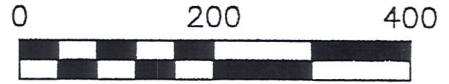

SCALE: 1"=200'

- 5/8" REBAR FOUND UNLESS OTHERWISE NOTED
- STONE FOUND
- 5/8" REBAR WITH I.D. CAP SET I.D. CAP MARKED "BAKER 6938"

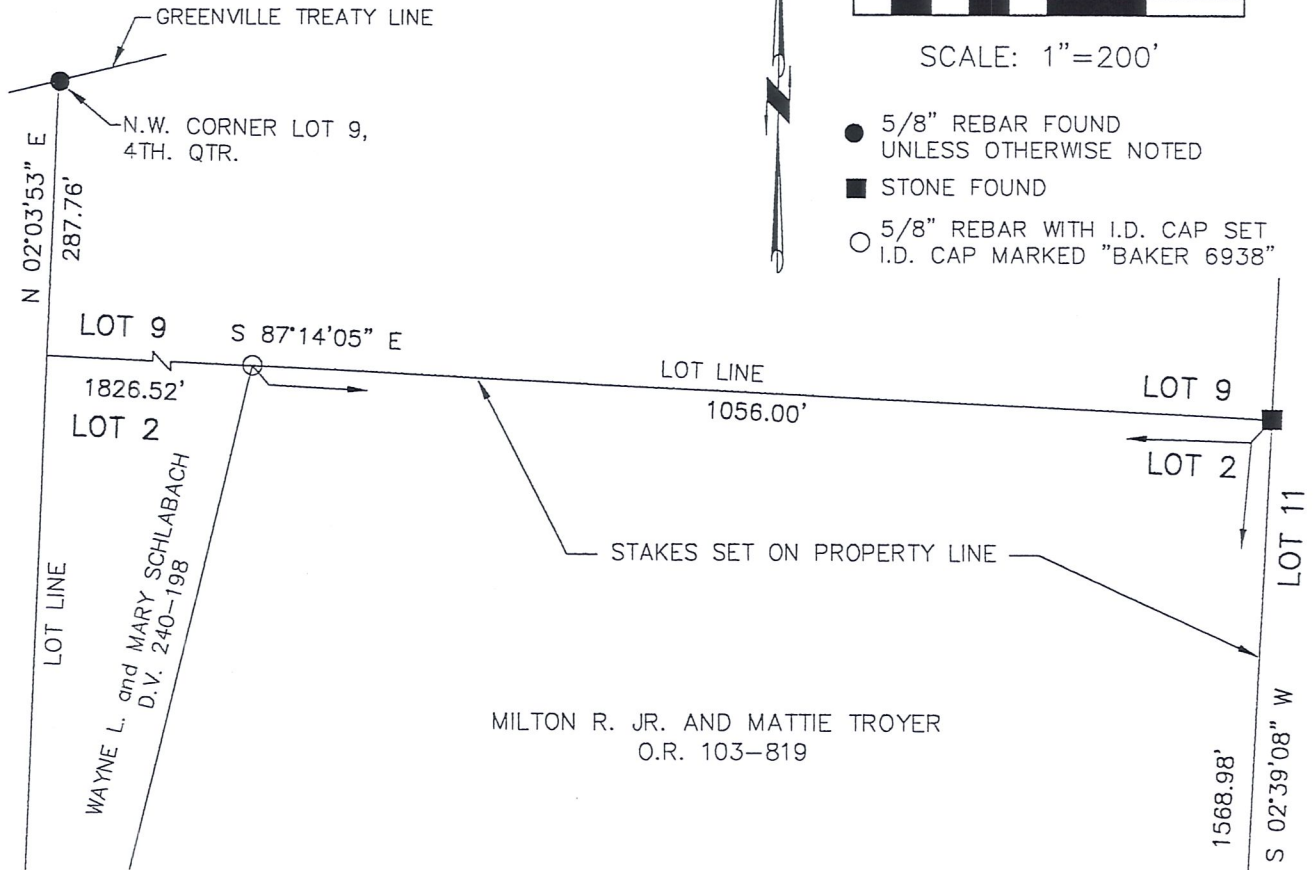

I CERTIFY THIS SURVEY TO BE CORRECT TO THE BEST OF MY KNOWLEDGE.

Jamie D. Darr
JAMIE D. DARR P.S. 7755

DATE: APRIL 5, 2007

JDD\FDB\AEG
File Name: WORK2\S-159-07\MLD



DONALD C. BAKER SURVEYING
138 N. CLAY ST.
MILLERSBURG, OHIO, 44654
PH. 330-674-4788
FAX. 330-674-6027

END OF LINE STAKING

4TH. QTR. T-10 N, R-7 W
3RD. QTR. T-10 N, R-6 W

LOT 2
LOT 1