


BEING PART OF: LOTS 6, 7, 8
SEC. 4
T. 10 N. R. 7 W.

THE COSHOCTON LAND SURVEYING SERVICE, INC.
233 S. FOURTH ST.
COSHOCTON, OHIO 43812

SURVEY FOR: Tom Mabeis
LAND OF BEST INVESTMENT
DATE: SEPTEMBER, 1980
SCALE: 1" = 200'

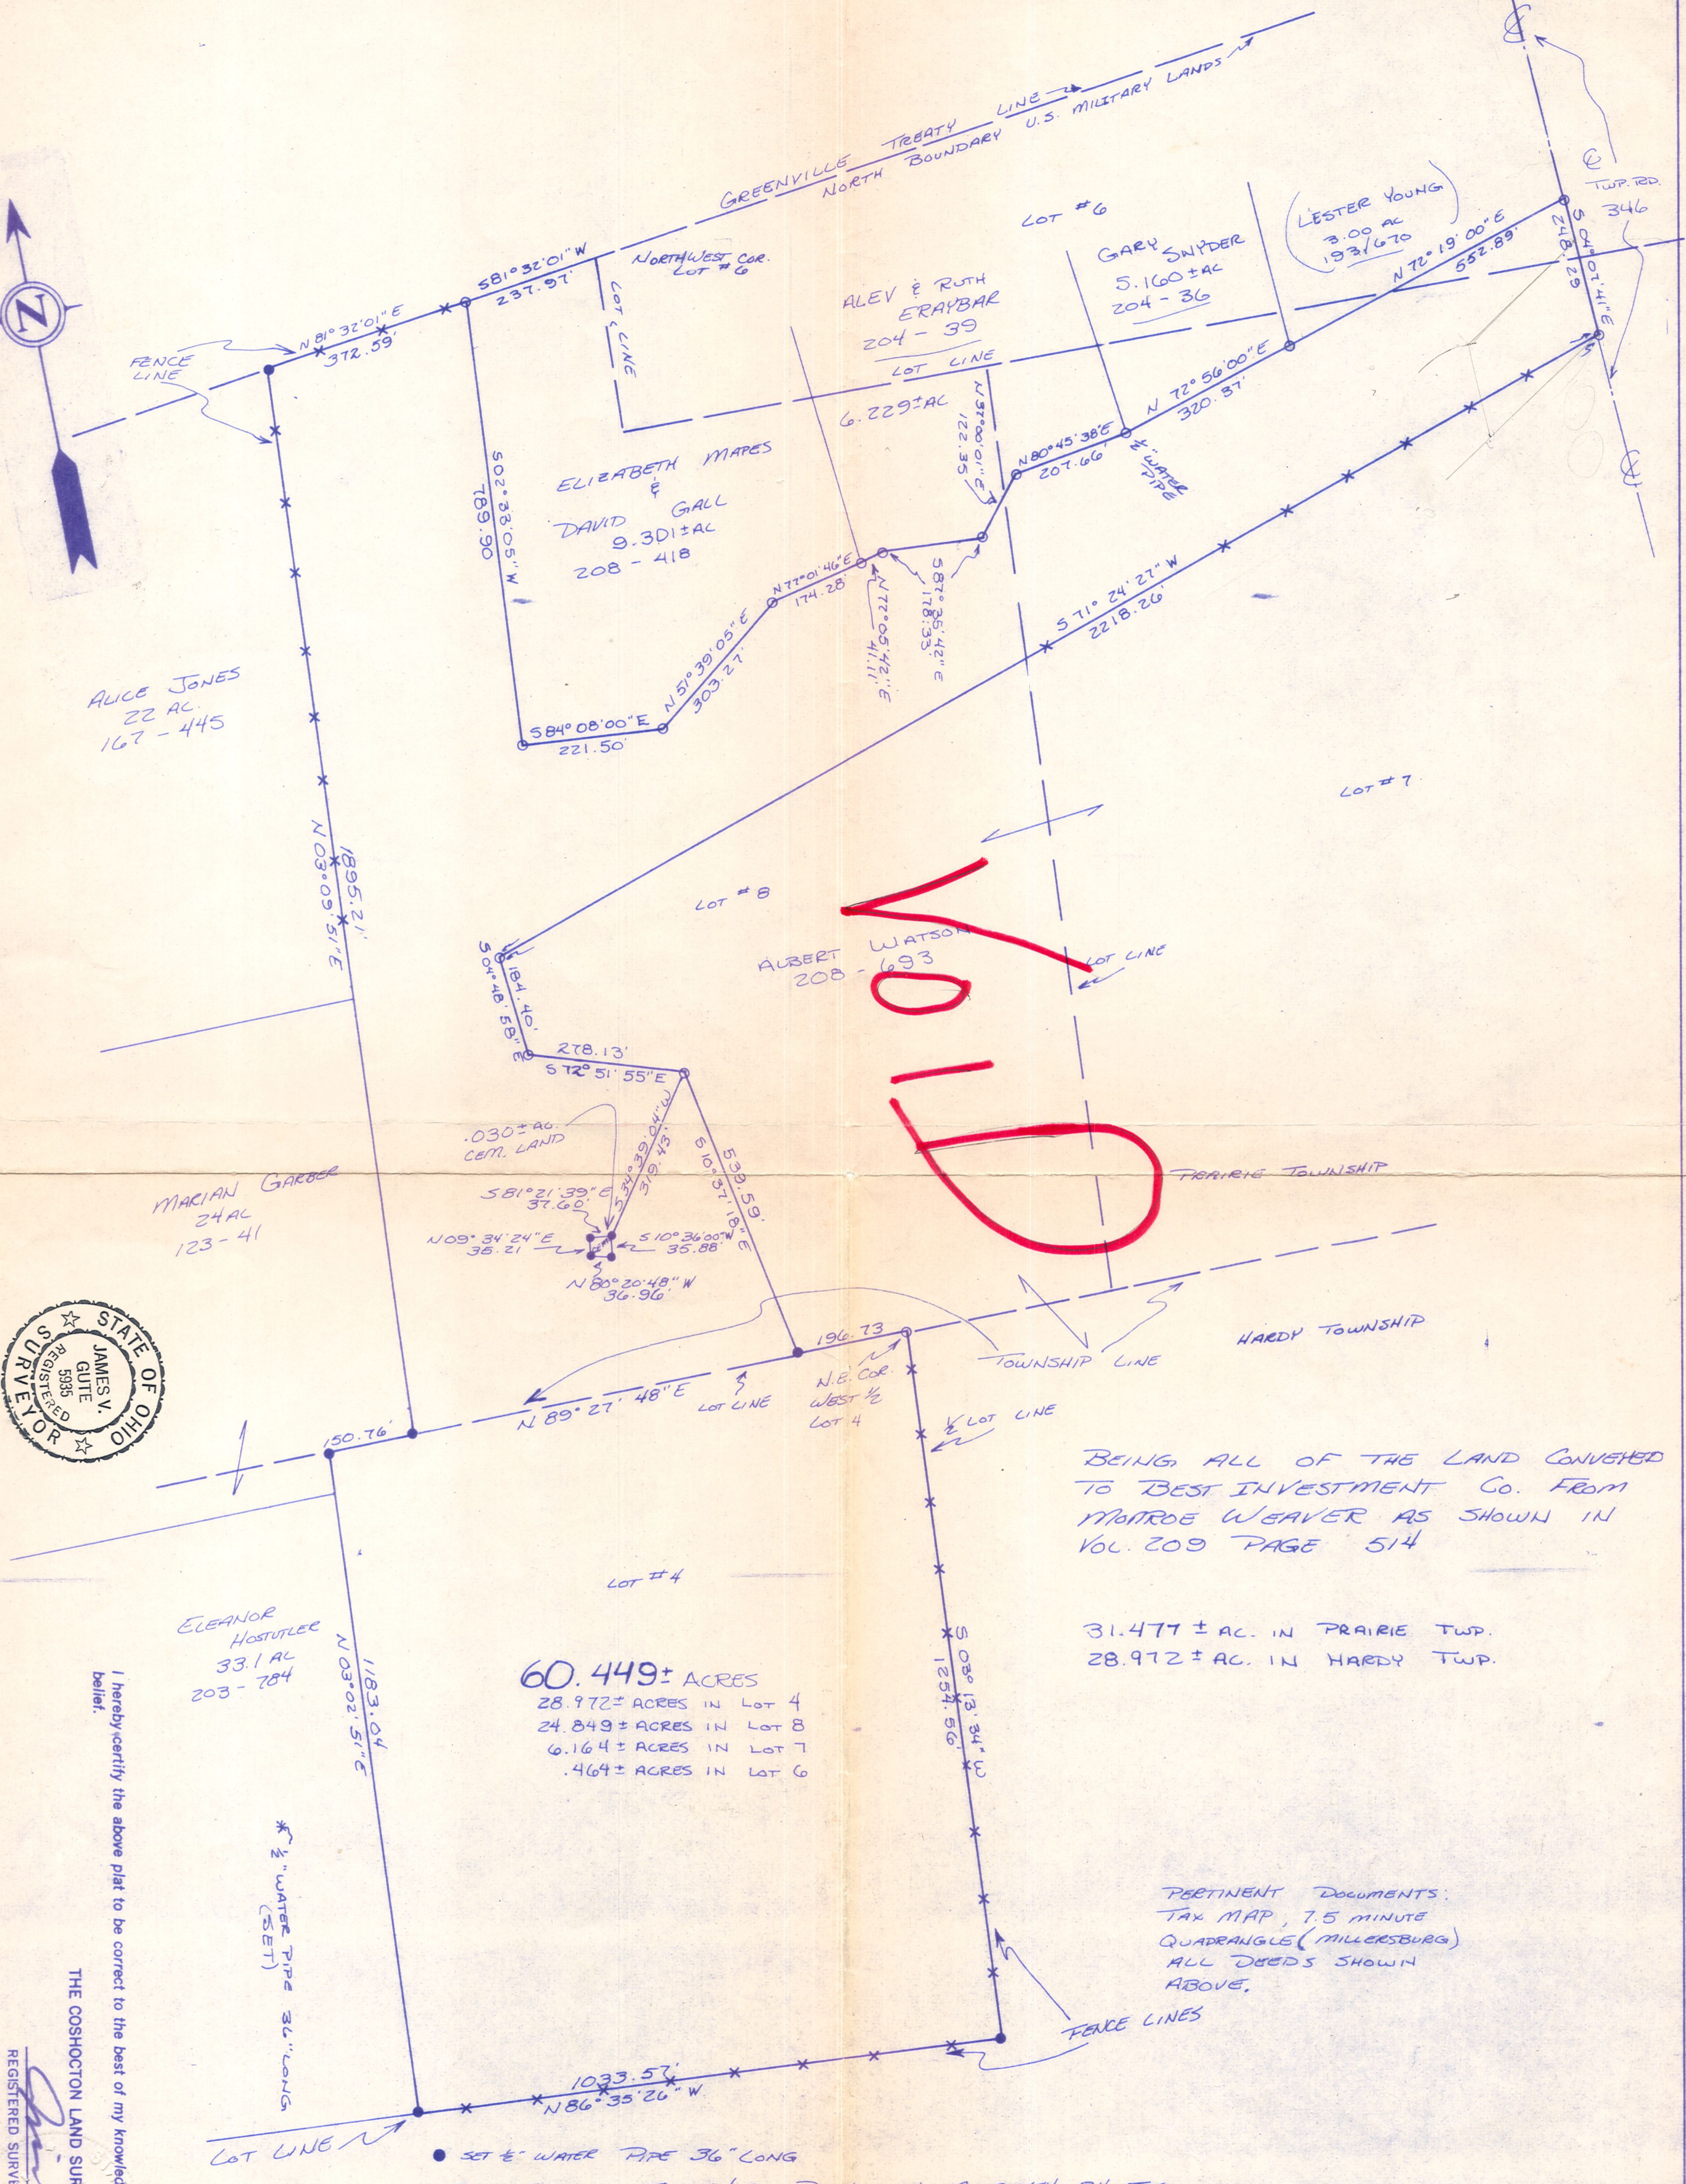

I hereby certify the above plat to be correct to the best of my knowledge and belief.

THE COSHOCTON LAND SURVEYING SERVICE

REGISTERED SURVEYOR
REGISTERED ENGINEER

- ⊗ SET WATER PIPE 36" LONG

BEARINGS FOR THIS WERE BASED ON A SURVEY BY THE COSHOCTON LAND SURVEYING SERVICE, FOR PAUL MILLER, LAND OF DAN WEAVER, DATED OCTOBER 1978.

60.449 ± ACRES
28.972 ± ACRES IN Lot 4
24.849 ± ACRES IN Lot 8
6.164 ± ACRES IN Lot 7
.464 ± ACRES IN Lot 6

BEING ALL OF THE LAND CONVEYED TO BEST INVESTMENT CO. FROM MONROE WEAVER AS SHOWN IN VOL. 209 PAGE 514

31.477 ± AC. IN PRAIRIE TWP.
28.972 ± AC. IN HARDY TWP.

PERTINENT DOCUMENTS:
TAX MAP, 7.5 MINUTE QUADRANGLE (MILLERSBURG)
ALL DEEDS SHOWN ABOVE.