PRAIRIE TOWNSHIP
S.E. QTR. SECTION 7
T-13N ; R-13W
HOLMES COUNTY. OHIO

(SURVEYED FOR CONRAD & LOIS MILLER)

0 100 200 400

SCALE: 1" = 200'

● IRON PIN FOUND

○ 5/8" REBAR WITH I.D. CAP SET
I.D. CAP MARKED "BAKER 6938"

RECEIVED
JAN 25 2000
Hol. Co. Tax Map Office

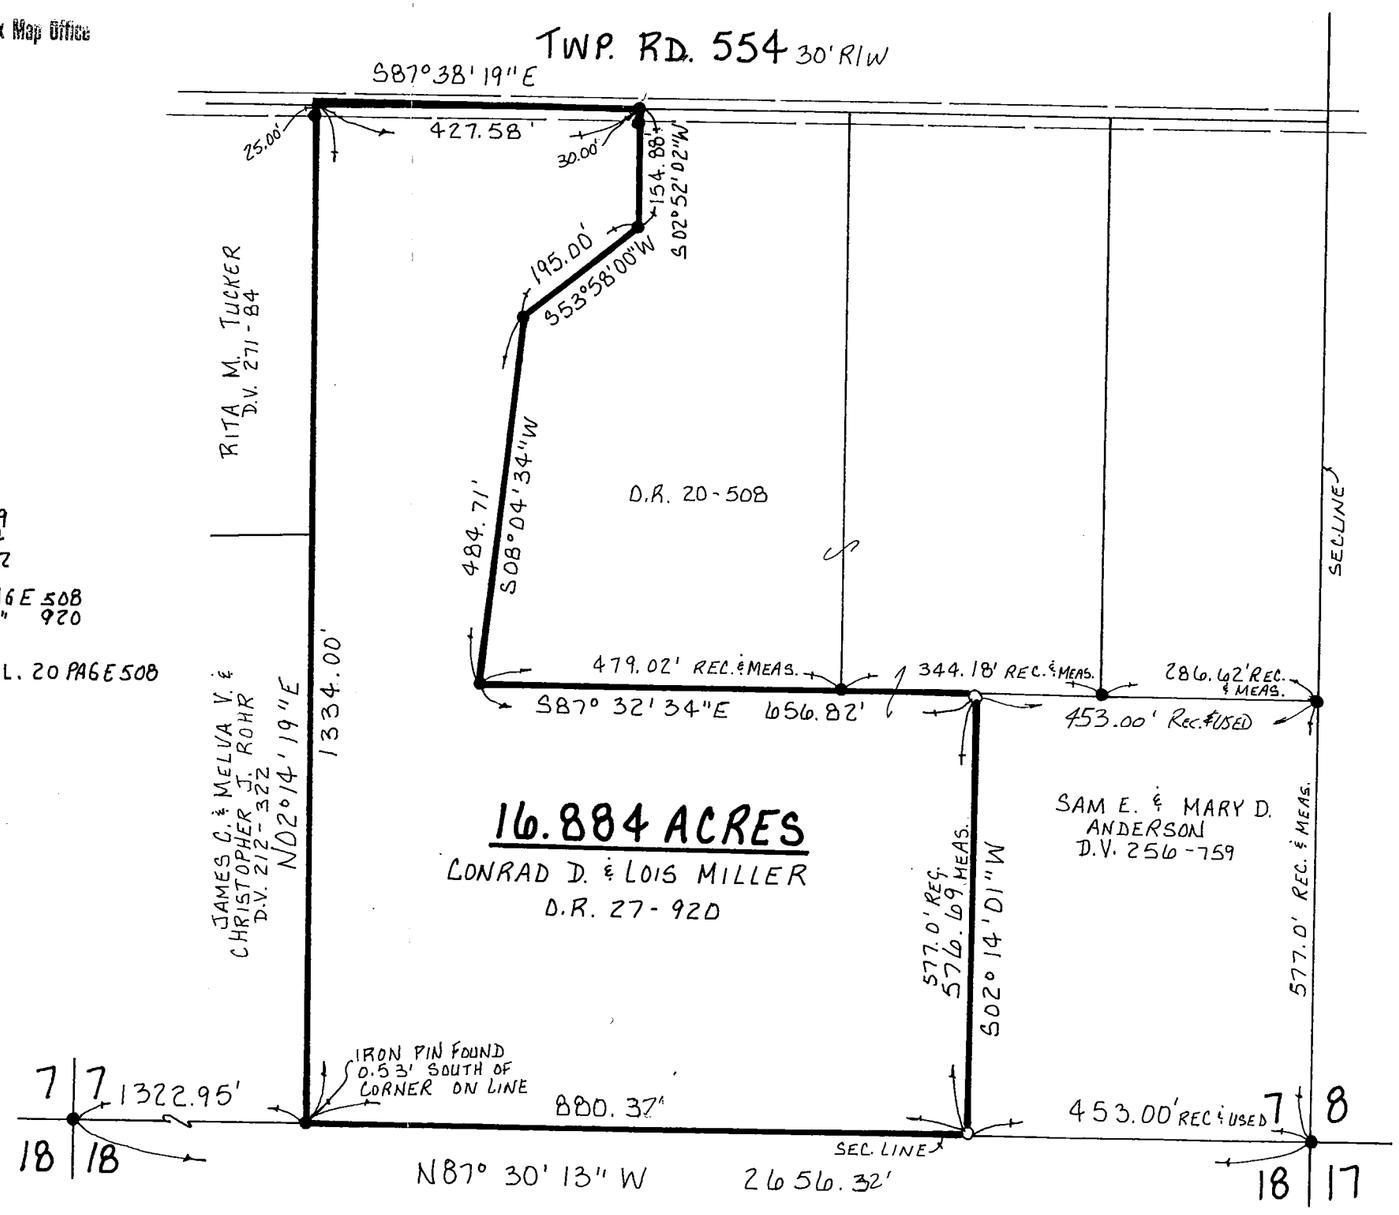

REFERENCES:

DEED VOL. 256 PAGE 759
" " 271 " 84
" " 212 " 327

OFFICIAL RECORD VOL. 20 PAGE 508
" " " 27 " 920

BEARINGS FROM O.R. VOL. 20 PAGE 508

STATE OF OHIO
DONALD C. BAKER
6938
REGISTERED
PROFESSIONAL SURVEYOR

I CERTIFY THIS SURVEY TO BE CORRECT TO THE BEST OF MY KNOWLEDGE.

Donald C. Baker

DONALD C. BAKER P.S. 6938

DONALD C. BAKER SURVEYING

138 N. CLAY ST
MILLERSBURG, OHIO 44654
PH: (330) 674-4788

JANUARY 24, 2000

#1600 - FJM
F.C.C. - F.D. BAKER