


PLAT of SURVEY for  
ROBERT C. CROSKY  
Part of the S.W. 1/4 of Sect. 9, T. 13, R. 13.  
PRAIRIE TWP. HOLMES CO.

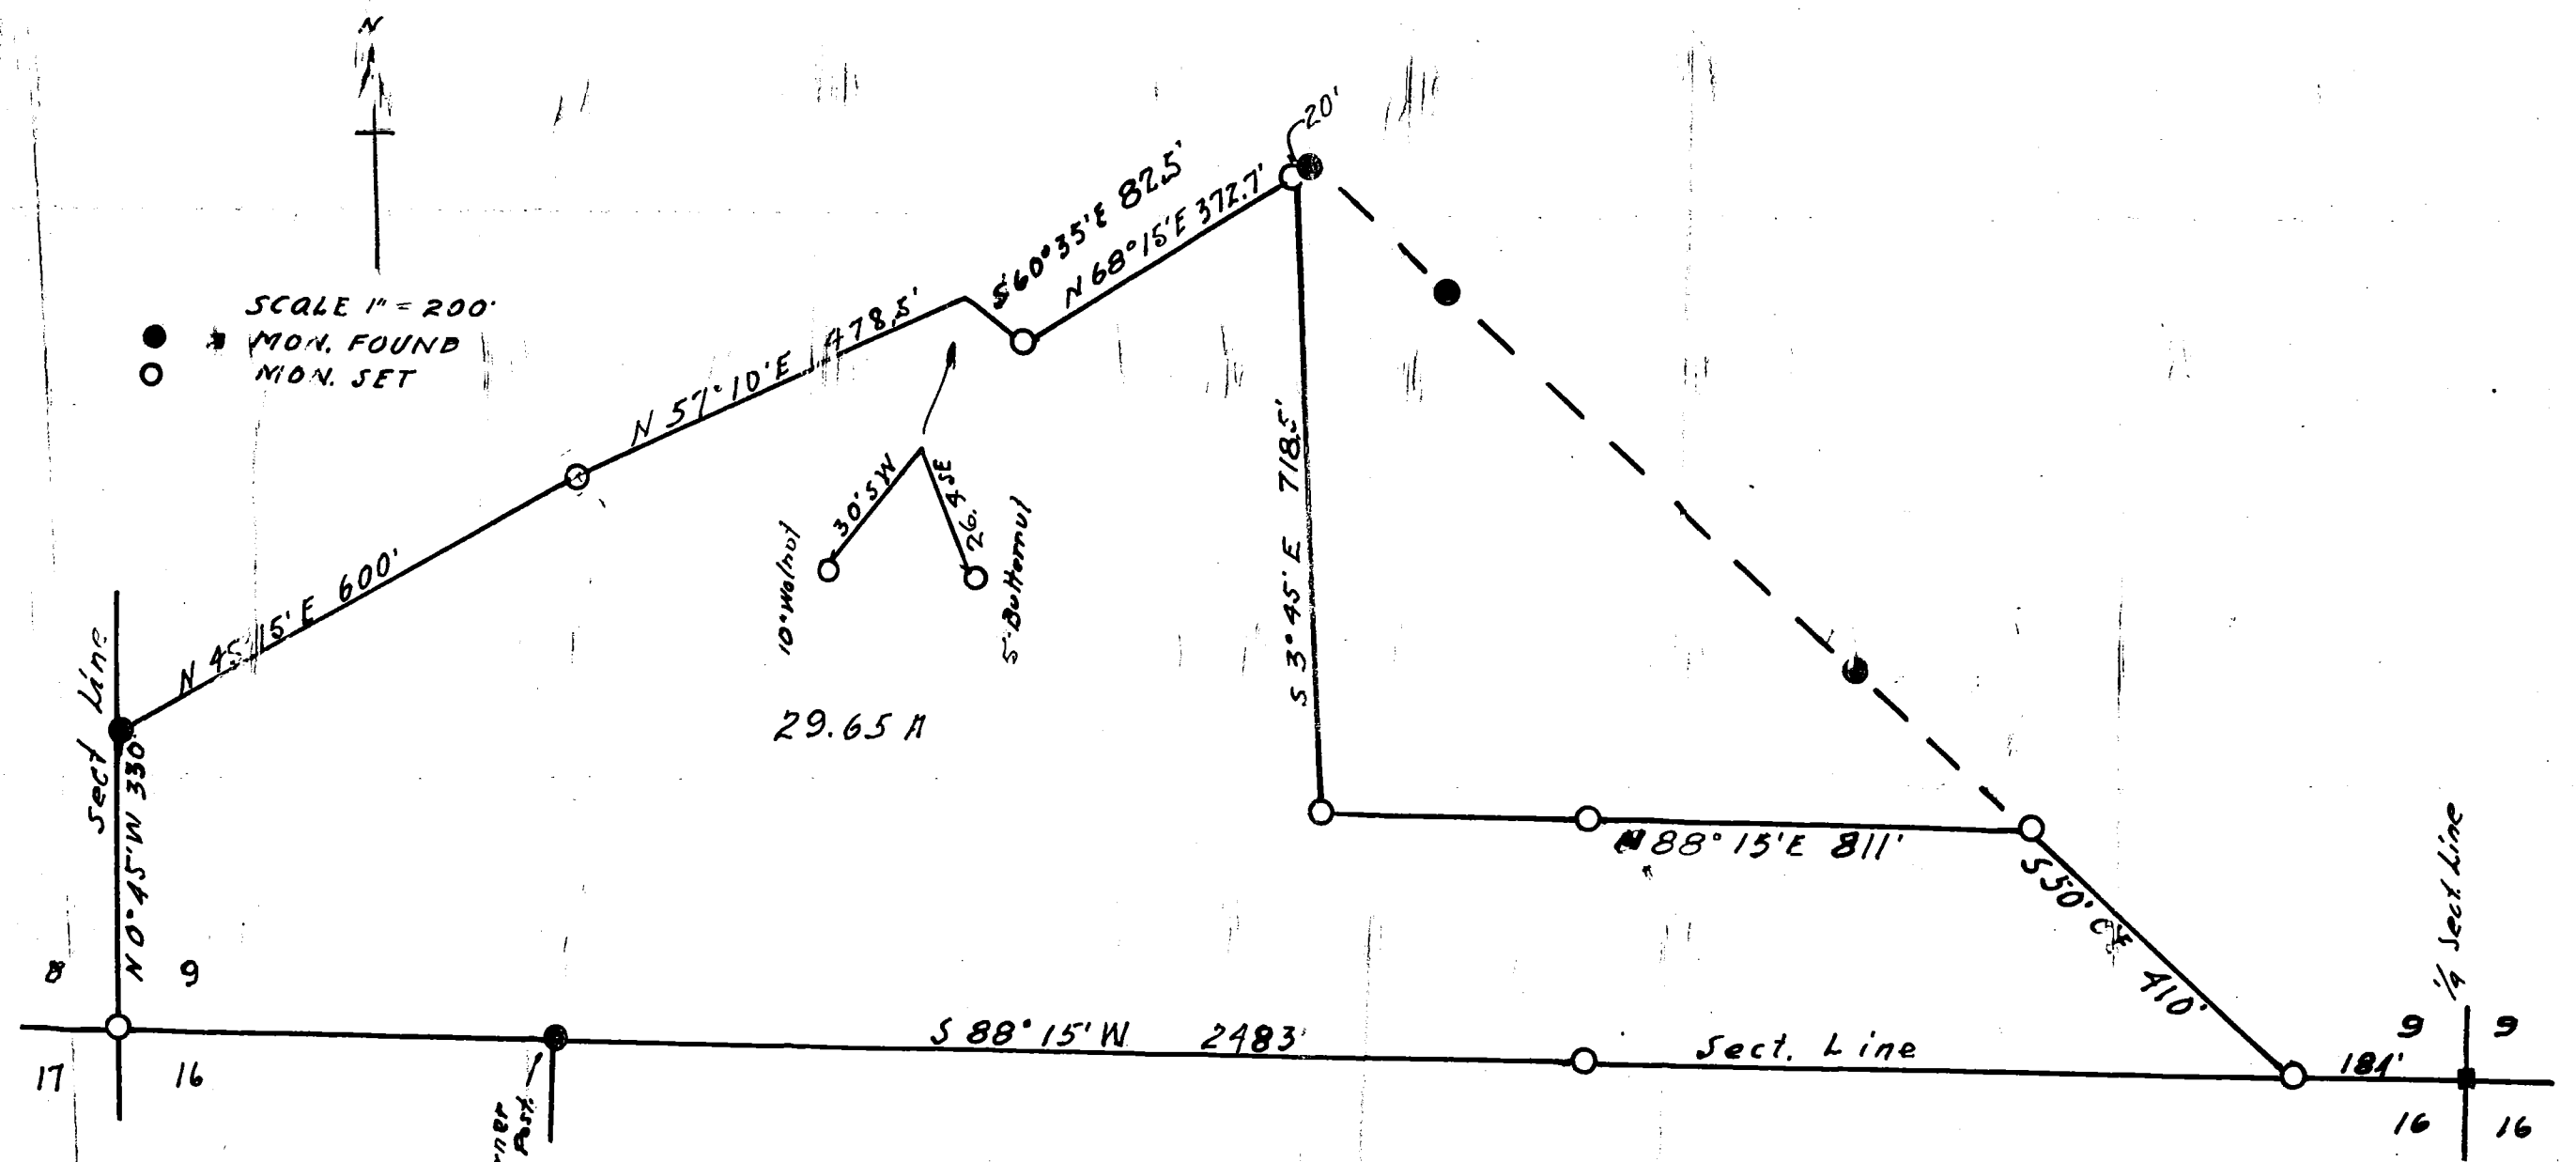

SCALE 1" = 200'  
● MON. FOUND  
○ MON. SET

I certify the above to be a correct plat of a survey  
made for Robt. C. Crosky in 1966.

Signed J. E. Poush  
Reg. Surv. No. 2686,  
Orville O. R. D. I.