

N.W. 1/4 Frac. 514
T13N R13W Vol. 151 Pg. 353

Hol. Co. Infirmiry

Vol. 151 Pg. 353

(Dead)
158.4'

231.8' Vol. 151 Pg. 353

N89°22'6" W 697.52' T.R. 244 60' R1W
(N89°0'E 708')

Presently owned by Alva McCluggage
1.975 Ac. (2 Ac.)

17.65'
I.P. Found
N0°41'0"E
107.35'

125.3'

I.P. Found

28.16 + 654.14 = 682.30'

28.16'

654.14' N89°19'0"W
N89°0'E 697.8' Vol. 151 Pg. 353

I.P. Found

187.14'

3.007 Ac. Part of
Vol. Pg.

30°41'0"W
204.97'

27.27' I.P. Set

262.82'

I.P. Set

587°38'50"E

N87°38'50"W

369.76'

I.P. Set

1.0 Ac. P.B. 3 Pg. 15
Presently owned by

N6°17'30"W
150.00'

0.988 Ac.

27.27' Kenneth Glatt

I.P. Found

262.82'

I.P. Found 587°38'50"E Survey
Vol. 151 Pg. 353

585°37'E 290.4'

7.184 Ac.

16.032 Ac.

Dead Vol. 151 Pg. 353 N100'W 1112.0'
Survey N1°40'25"W 1132.93' (Calculation)

150.00'
45 R.B. 3

294.81'

147.50'
Vol. 151 Pg. 353 N5°42'W
W6°17'30"W

37.99' I.P. Set

140.73'

I.P. Set

589°44'10"E

58.50'

Presently owned
by David
Linkenfelter

N6°17'30"W
147.50'

0.601 Ac.
Survey
61 Ac.
P.B. 3 Pg. 42-B

29.92'

148.80'

52.50'

I.P. Set

I.P. Found

W89°44'10"W Survey

N89°0'E P.B. 3 Pg. 42-B

226.32' (Calculated)

Dead N5°42'W
N6°17'30"W
147.50'
55 E 6151
Vol. 151 Pg. 250.5'

322.7

P.K. Nail Found



228.40' (Calculated)

I.P. Found

589°0'0"W 541.16'
Vol. 151 Pg. 353 545.5'

I.P. Found

Dead Vol. 151 Pg. 353 N112°E 1102.02' Survey (by calculation)

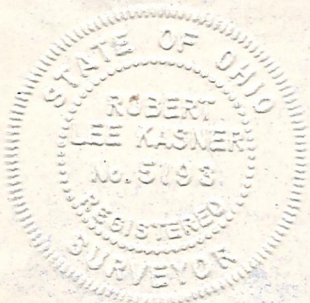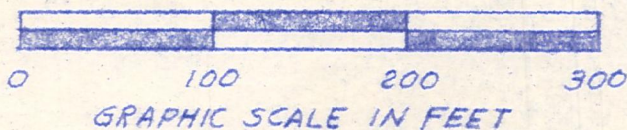

PLAT OF A RESURVEY OF
VOL. 151 PG. 353
Known as part of Frac. 1/4, T13N,
R13W of Prairie Twp, Hol. Co., Ohio
Robert L. Kasner, P.S. 5193 P.E. 28820

MAP OFFICE COPY