



0 100 200 400
 SCALE: 1" = 200'
 ■ STONE FOUND
 ▲ R.R.-SPIKE FOUND
 ● IRON PIN FOUND
 ○ 5/8" RE BAR WITH I.D. CAP SET
 I.D. CAP MARKED "BAKER 6938"

PRAIRIE TOWNSHIP
 N.E. & N.W. QTR. SECTION 15
 T-13N; R-13W
 HOLMES COUNTY, OHIO
 (SURVEYED FOR: CRILow BRos.)

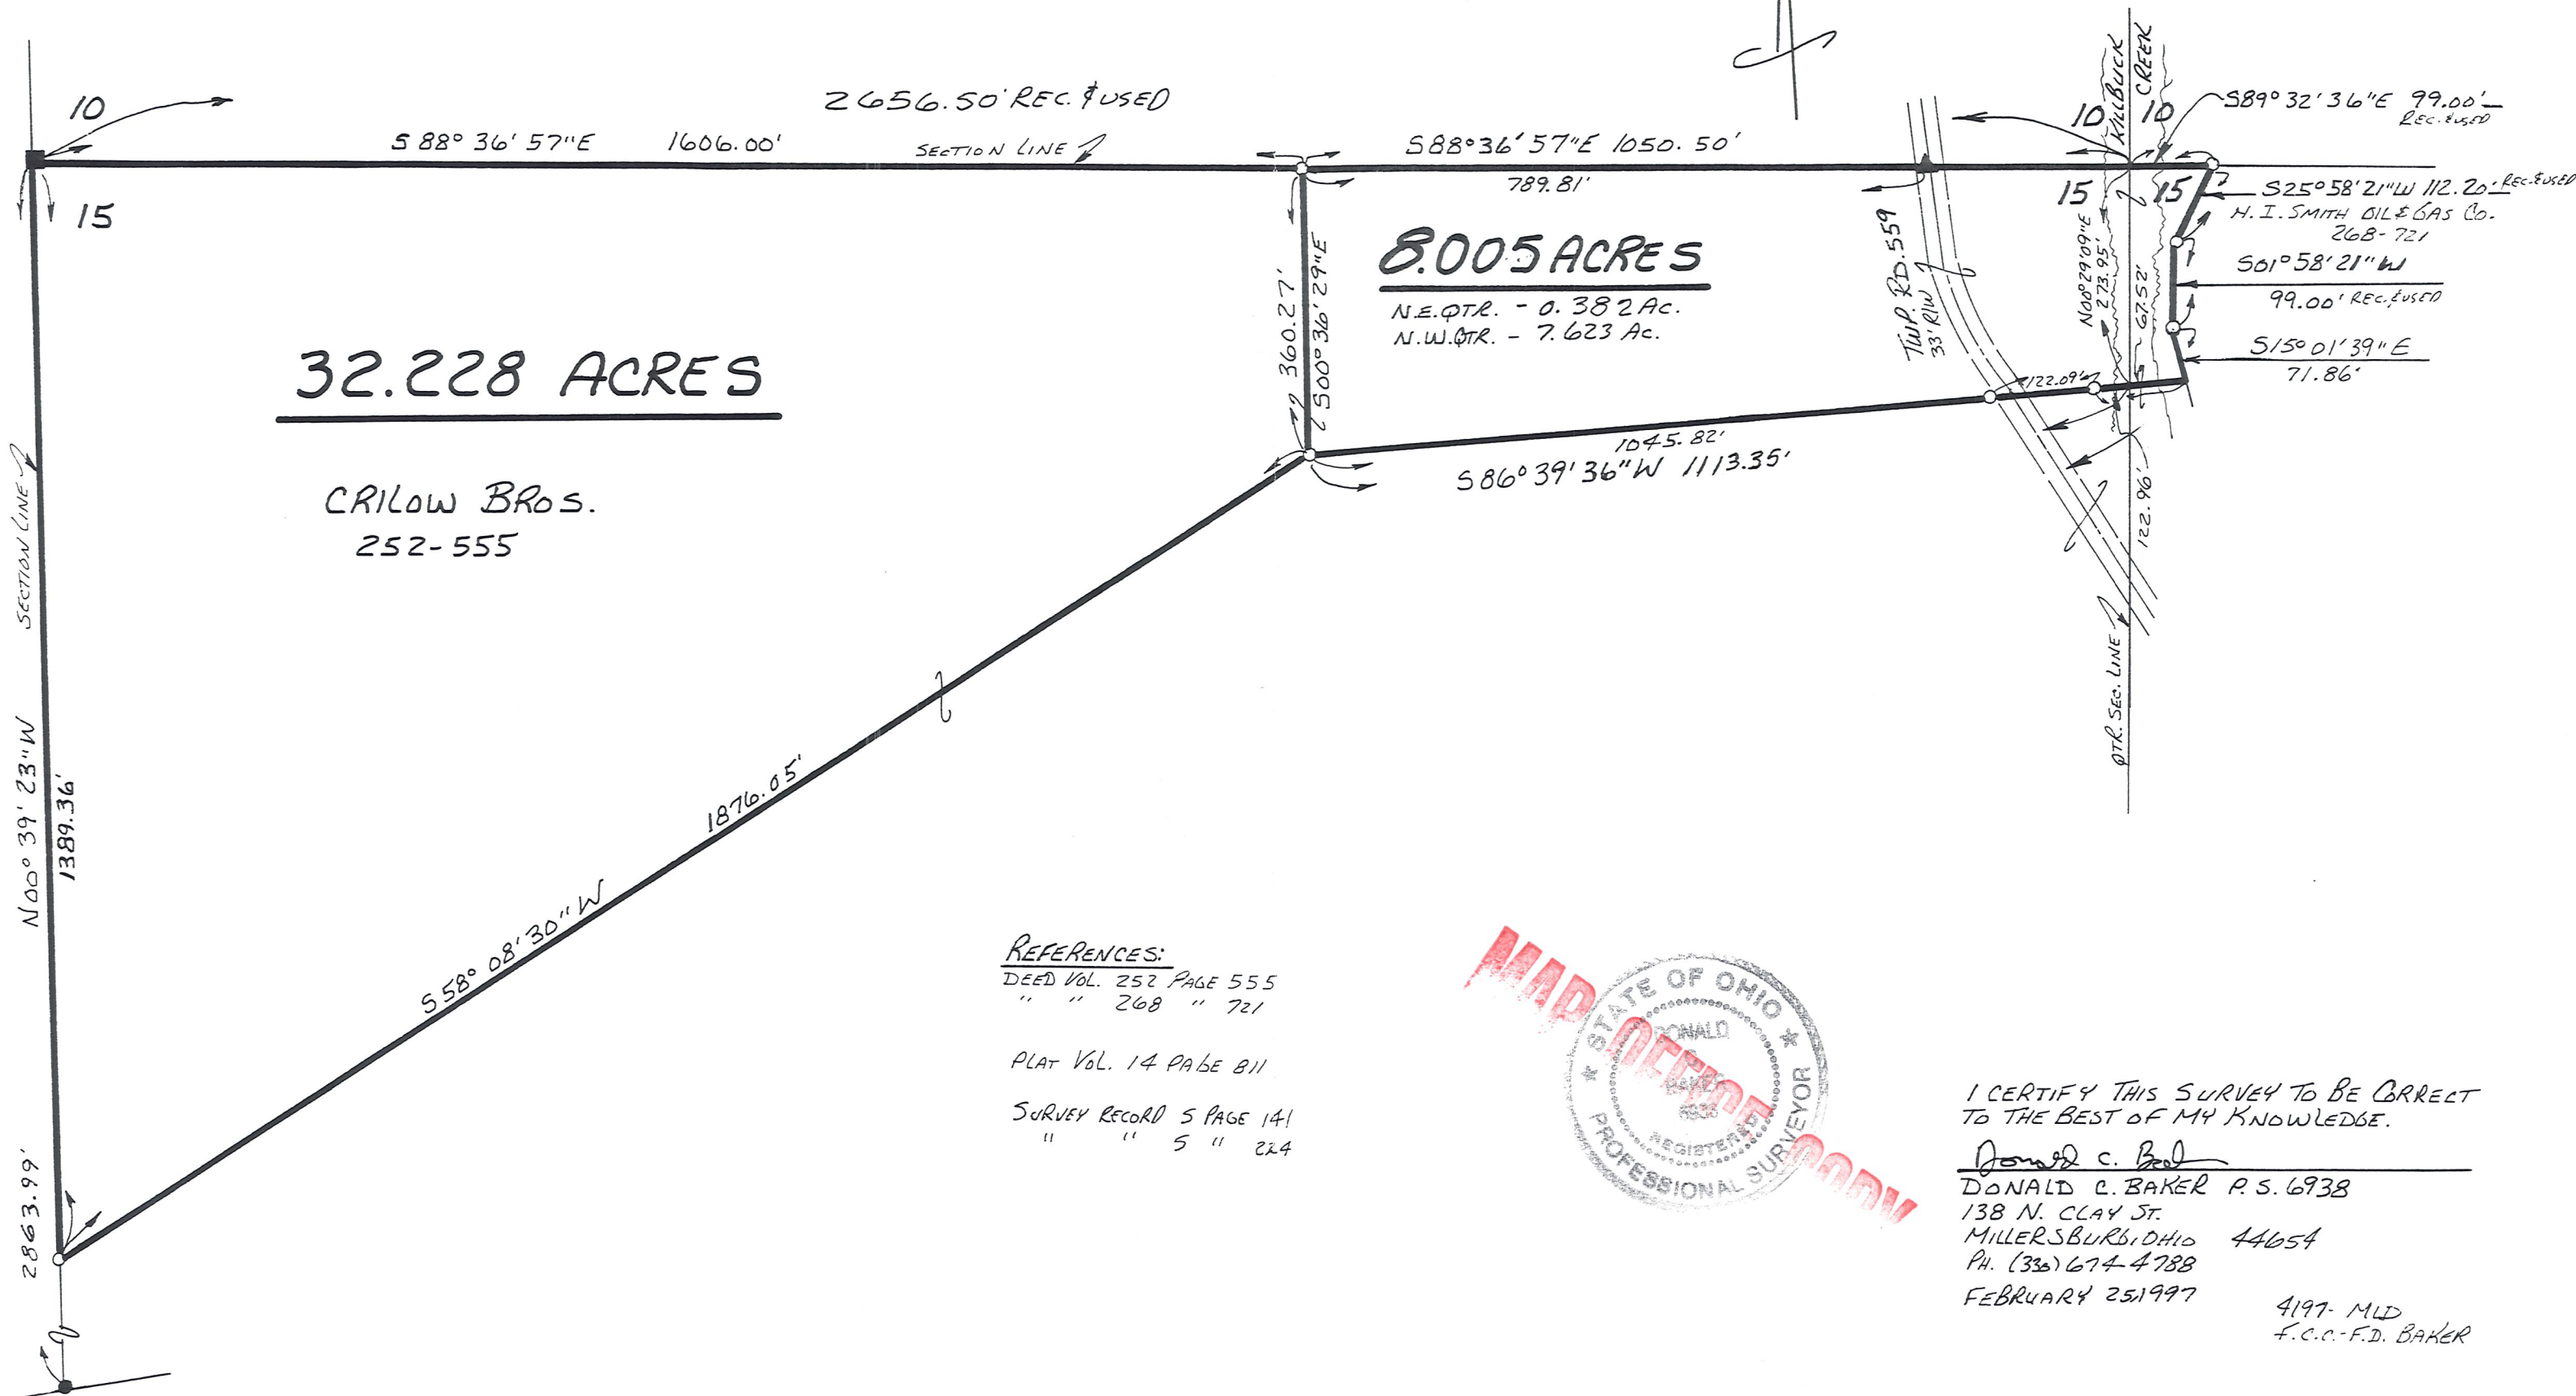

REFERENCES:
 DEED Vol. 252 PAGE 555
 " " 268 " 721
 PLAT Vol. 14 PAGE 811
 SURVEY RECORD 5 PAGE 141
 " " 5 " 224

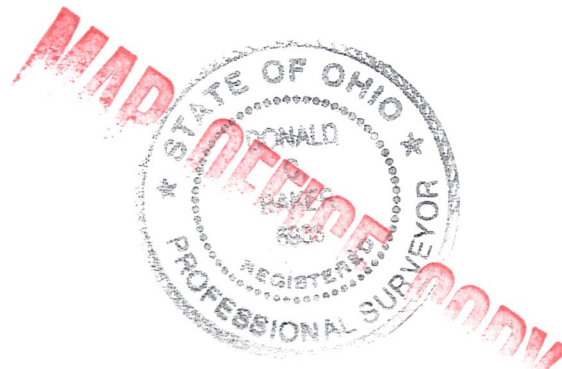

I CERTIFY THIS SURVEY TO BE CORRECT TO THE BEST OF MY KNOWLEDGE.

Donald C. Baker
 DONALD C. BAKER P.S. 6938
 138 N. CLAY ST.
 MILLERSBURG, OHIO 44654
 PH. (336) 674-4788
 FEBRUARY 25, 1997

4197-MLD
 F.C.C.-F.D. BAKER