L.P.C.
PHOTO 1173 (SEC. 5)
PHOTO 1176 (SEC. 32)

S-30-81
M-43-83

PRAIRIE TOWNSHIP
PT. OF S.W. QTR. SECTION 32 (T-14N ; R-13W)
℄
PT. OF N.W. QTR. SECTION 5 (T-13N ; R-13W)
HOLMES COUNTY
OHIO

N

SCALE: 1"=200'

○ IRON COR. SET
● IRON COR. FOUND
□ STONE FOUND

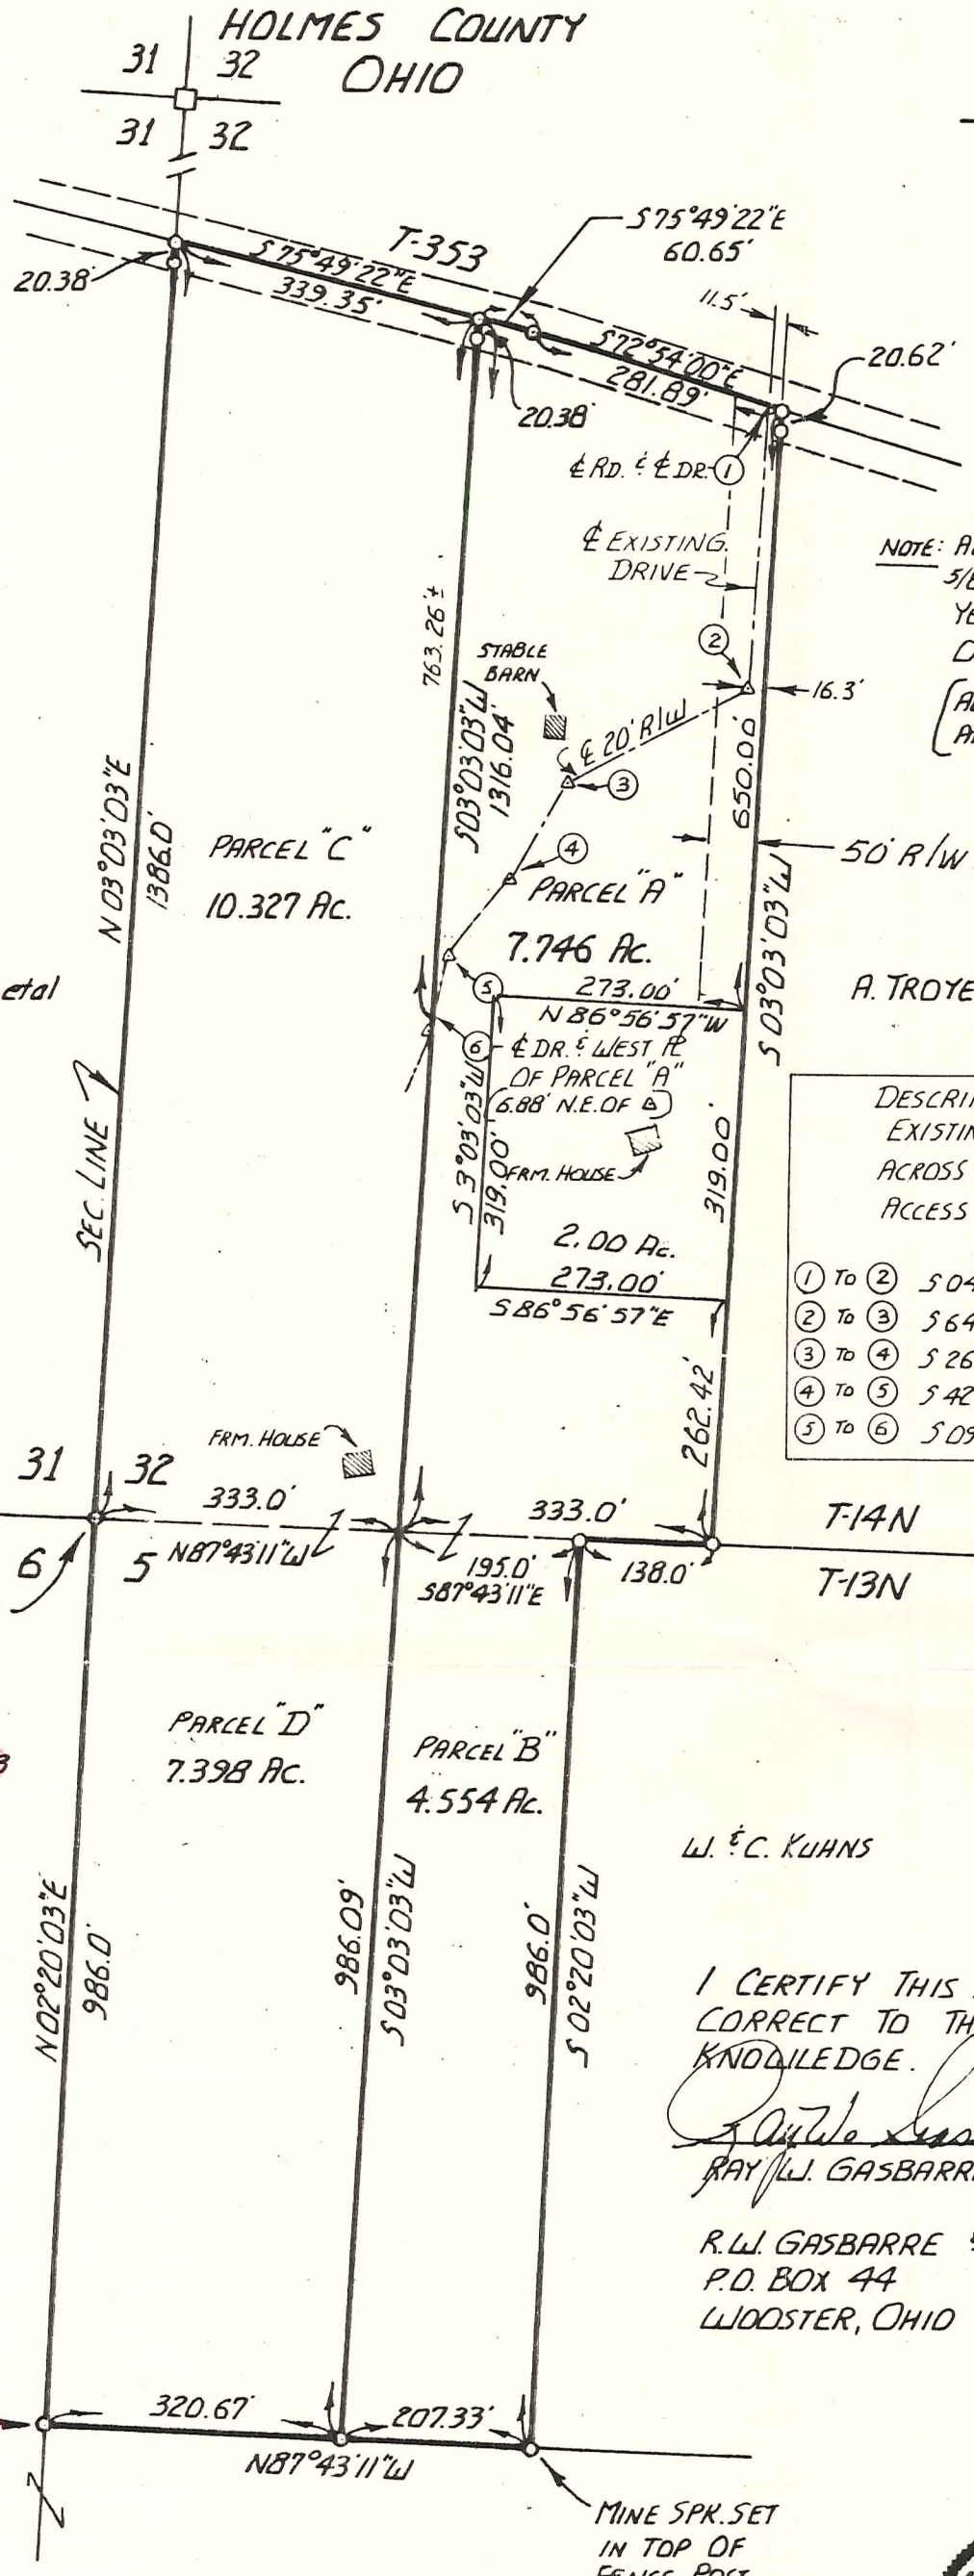

NOTE: ALL IRON COR.'S SET ARE 5/8"x30" REBARS WITH YELLOW I.D. CAP UNLESS OTHERWISE NOTED
(ALL REBARS SET IN RD. ARE 5/8"x15" - NO CAP

PARCELS "A" & "B"

PAUL A. ALFARO, M.D.
HIS 1/2 INTEREST TO
WESLEY P. SHANK

PARCELS "C" & "D"

WESLEY P. SHANK
HIS 1/2 INTEREST TO
PAUL A. ALFARO, M.D.

H. GOODWILL, etal

A. TROYER

LAND OWNERS:

PAUL A. ALFARO, M.D.
& WESLEY P. SHANK
DEED VOL. 110 PG. 472

DESCRIPTION FOR ℄ EXISTING DRIVE ACROSS PARCEL "A" FOR ACCESS TO PARCEL "C"

① To ②	S 04°01'25"W	(304.78')
② To ③	S 64°07'40"W	(222.68')
③ To ④	S 26°02'32"W	(118.54')
④ To ⑤	S 42°02'28"W	(104.00')
⑤ To ⑥	S 09°52'26"W	(84.12')

PARCEL A - AMENDED 9-14-83
Ray W. Gasbarre

FOR MARY E. SHANK
DEED VOL. 216 PG. 380

G. SCHLEGEL

W. & C. KUHNS

I CERTIFY THIS SURVEY TO BE CORRECT TO THE BEST OF MY KNOWLEDGE.

Ray W. Gasbarre
RAY W. GASBARRE P.S. 4153

R.W. GASBARRE & ASSOC. INC.
P.O. BOX 44
WOOSTER, OHIO 44691

(COMPLETED 8-11-81)

STATE OF OHIO RAYMOND W. GASBARRE 4153 REGISTERED

MAP OFFICE COPY