


PRAIRIE TOWNSHIP
S.W. QTR. SEC. 33
TWP. 14 RANGE 13
HOLME COUNTY
OHIO
Dec. 1969

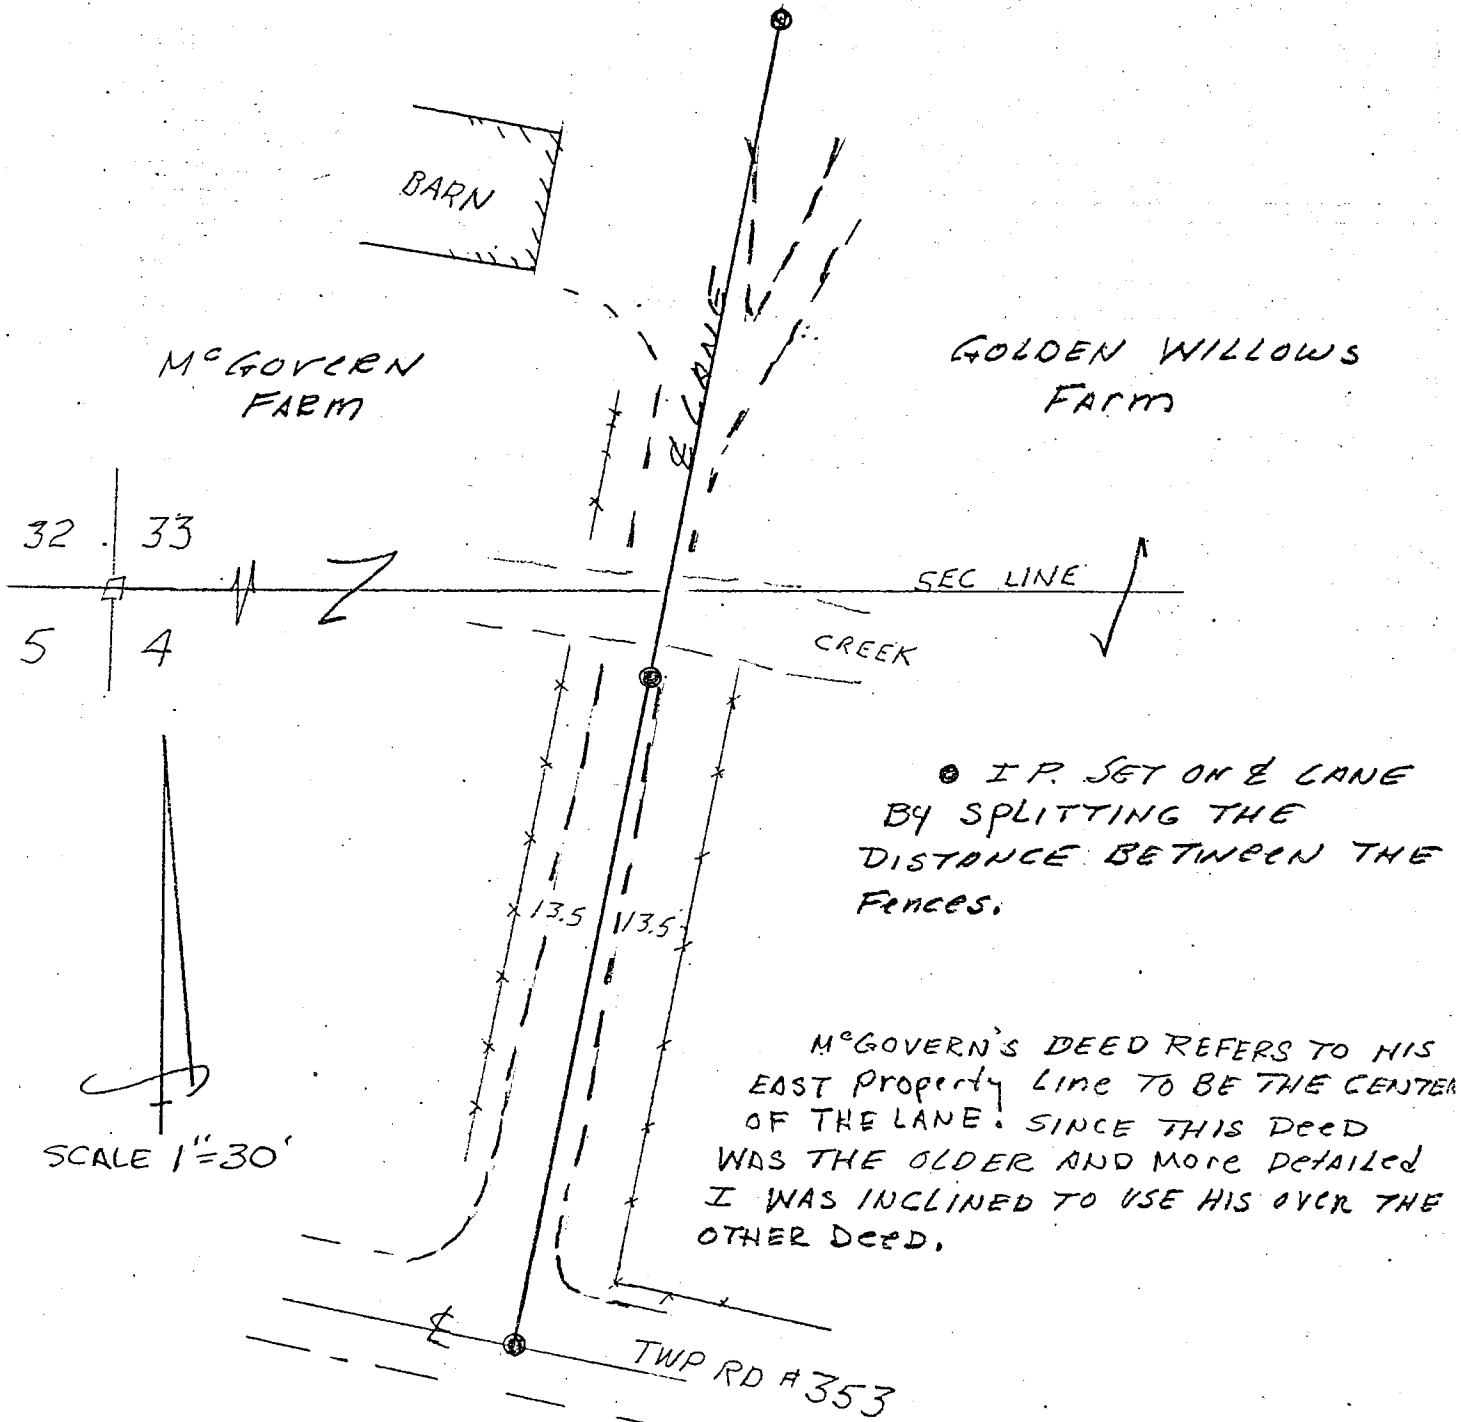

MAP OFFICE COPY