

Adam David Brandt
Vol. 230 Pg. 162

stone F'd at N.E. crnr S.E. 1/4
Sec. 4, T8N, R8W
P.B. 6 Pg. 18 paid no attention
to this stone at all. Hence
the North Line this survey
will not agree with
South Line of that one.

P.B. 6 Pg. 18

I. Pipe F'd 1980
N.W. crnr N.E. 1/4 S.E. 1/4 Sec. 4, T8N, R8W

586°27'21"E 1,323.57'

It is called out in
P.B. 10 Pg. 519

S.E. 1/4 Sec. 4, T8N, R8W
Richland Twp., Hol. Co., Ohio

60.6911 Ac.

Joseph A. & Helen A. McDowell
Vol. 117 Pg. 143
Vol. 242 Pg. 362

This survey is of the lands of Joseph A. &
Helen A. McDowell in Richland Twp.

500°00'59"W
1,957.51'

Joseph A. & Helen A.
McDowell
Vol. 117 Pg. 143
Vol. 242 Pg. 362

Sec. 3, T8N, R8W
Killbuck Twp.,
Hol. Co., Ohio

16 ±
Mentioned Vol. 71 Pg. 293
Wm. D. McDowell

RRS called for, could
not find under
new pavement

Pond
Small ditch from pond.
Pinched pipe found,
very loose, tightened
it.

I. Pin set 1980

585°30'15"E 596.41'

587°24'30"E 585.15'


93.34'

Pinched Pipe F'd

Pinched pipe F'd
bent somewhat to S.R. 520
the North but tight. 587°54'30"E
96.71

Dallas L. Bucklew
Vol. 145 Pg. 320

2.198 Ac. P.B. 8 Pg. 375 does
not indicate that it was
run Westward.
Robert P. & Libby A. Wengerd
Vol. 233 Pg. 290
P.B. 8 Pg. 375

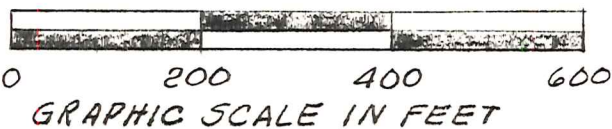

PLAT OF A SURVEY FOR
JOSEPH A. McDOWELLE et ux
Known as part of the S.E. 1/4
of Sec. 4, T8N, R8W, of Rich-
land Twp., Hol. Co., Ohio
Robert L. Kasner P.S. 5193
P.E. 28820
4116190

Rita G. Felix Vol. 171 Pg. 593
Vol. 192 Pg. 595
Vol. 200 Pg. 308

Erwin F. Felix Vol. 171 Pg. 589
Vol. 171 Pg. 591
Vol. 171 Pg. 593

Donald B. & Greta C. Snyder
Vol. 213 Pg. 202
P.B. 8 Pg. 755
N 25° 11' E 1,958.97'



I. Pin set 1980

I. R set 1980

151.14'

578.19'

1229.66'