

RICHLAND TOWNSHIP
 N.E. QTR. SECTION 5
 T-8N; R-8W
 HOLMES COUNTY, OHIO

0 50 100 200



SCALE: 1" = 100'

- STONE FOUND
- IRON PIN FOUND
- 5/8" RE BAR WITH I.D. CAP SET
I.D. CAP MARKED "BAKER 6938"

REFERENCES:

DEED VOL. 219 PAGE 242
 " " 247 " 352

PLAT VOL. 12 PAGE 441



I CERTIFY THIS SURVEY TO BE CORRECT
 TO THE BEST OF MY KNOWLEDGE.

Donald C. Baker

DONALD C. BAKER P.S. 6938

5958 T.R. 322


MILLERSBURG, OHIO 44654

PH. (216) 674-4788

AUGUST 24, 1995

44295-MLS

REVISED OCTOBER 9, 2002

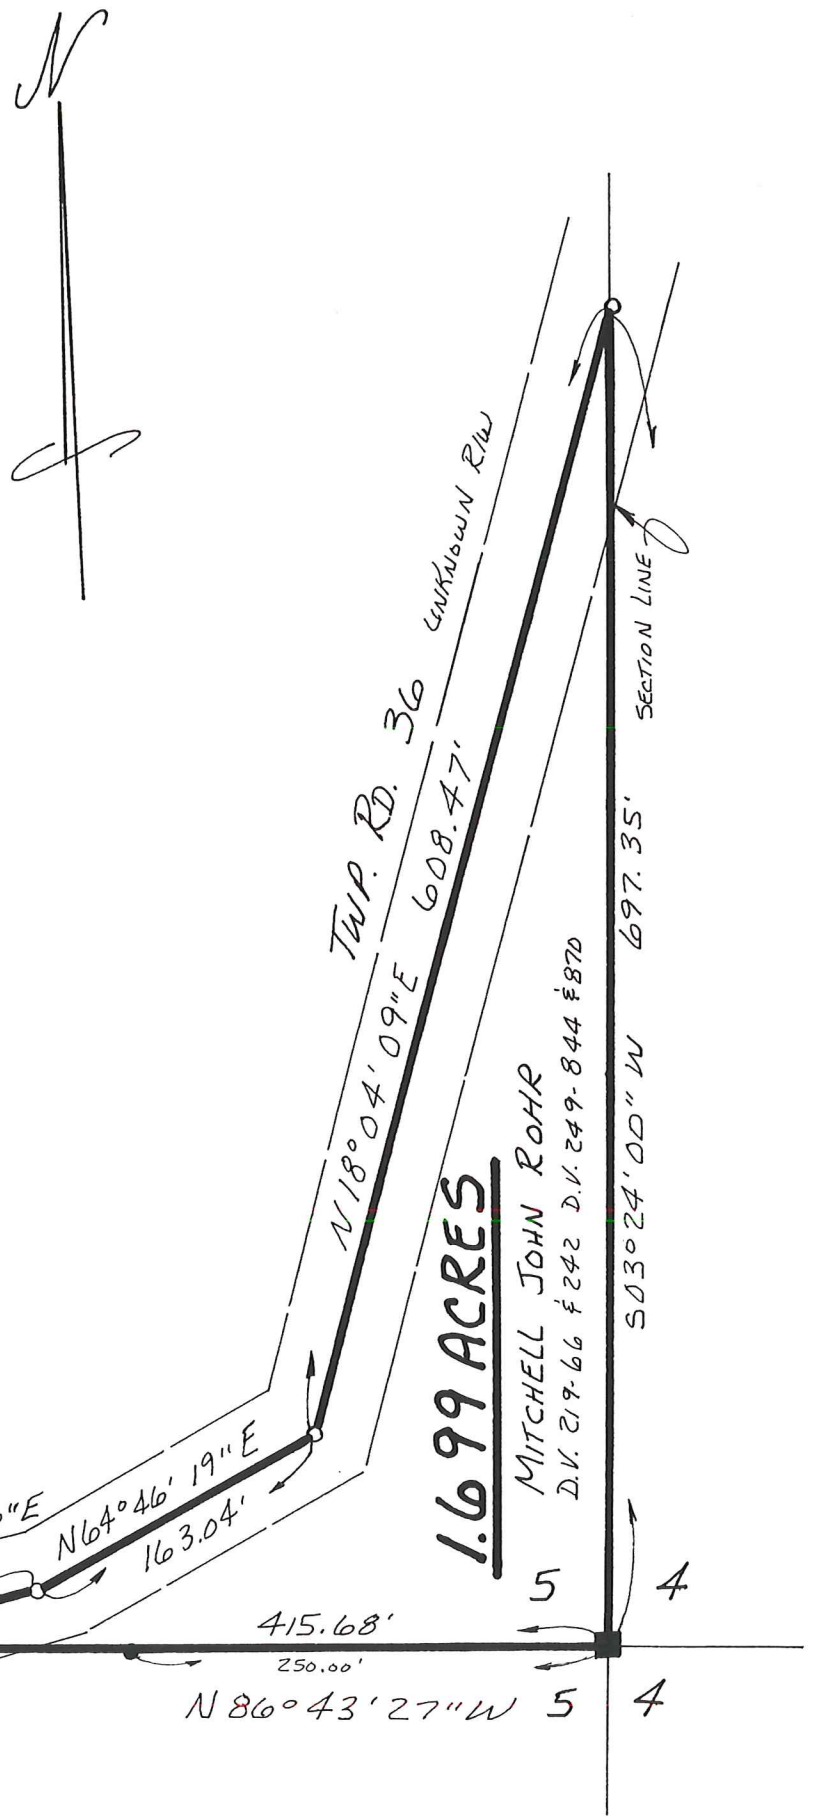

1.699 ACRES

MITCHELL JOHN ROHR

D.V. 219-66 §242 D.V. 249-844 §870

697.35'


TWP. RD. 36
 608.47'

N78°30'46"E
 122.60'
 N64°46'19"E
 163.04'

415.68'
 250.00'

N86°43'27"W 5 4

QTR. SEC. LINE