

SCALE: 1"=100'


- STONE FOUND
- 5/8" REBAR FOUND
UNLESS OTHERWISE NOTED
- 5/8" REBAR SET WITH I.D. CAP
I.D. CAP MARKED "BAKER 6938"

REFERENCES

- O.R. VOL. 265 PAGE 4274
- O.R. VOL. 247 PAGE 294
- O.R. VOL. 162 PAGE 193
- PLAT VOL. 2 PAGE 479
- PLAT VOL. 18 PAGE 580
- PLAT VOL. 10 PAGE 175
- BEARINGS FROM PLAT VOL. 2 PAGE 479

RICHLAND TOWNSHIP
S.E. QTR. SECTION 7
T-8 N; R-8 W
HOLMES COUNTY, OHIO

SURVEYED FOR: HERB MACKEY

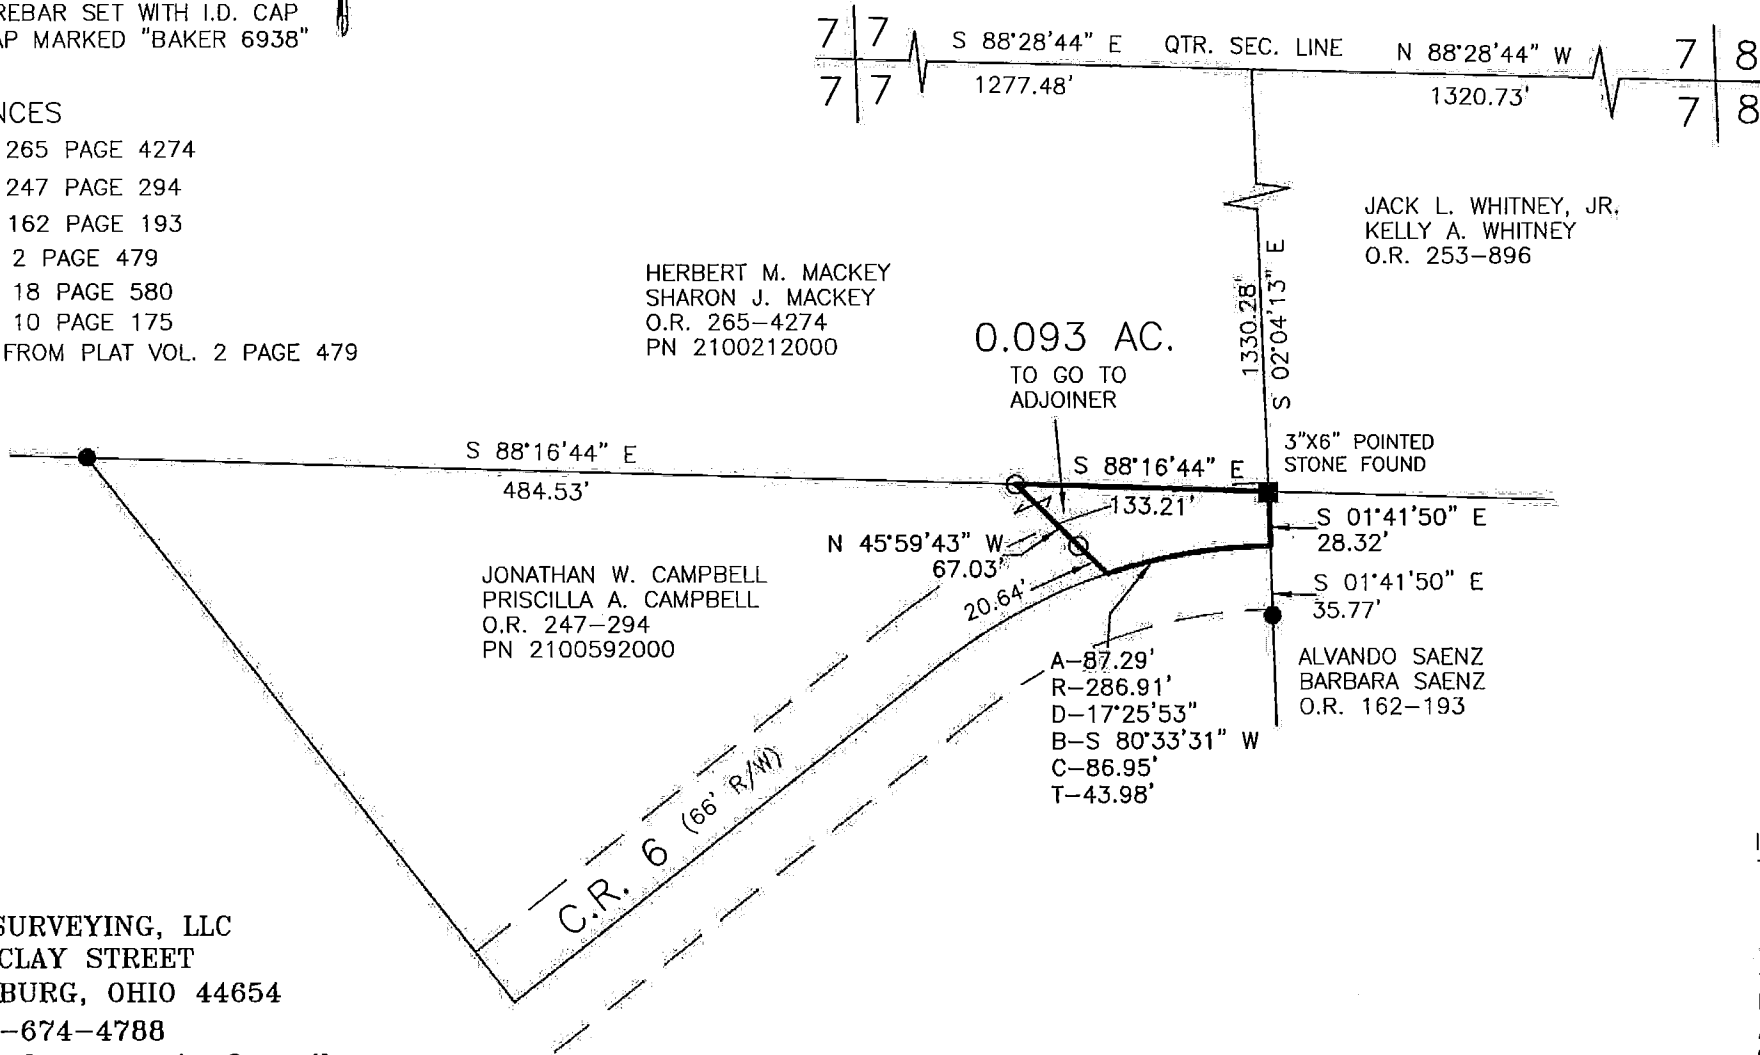

HERBERT M. MACKEY
SHARON J. MACKEY
O.R. 265-4274
PN 2100212000

JACK L. WHITNEY, JR.
KELLY A. WHITNEY
O.R. 253-896

S 88°16'44" E
484.53'

JONATHAN W. CAMPBELL
PRISCILLA A. CAMPBELL
O.R. 247-294
PN 2100592000

N 45°59'43" W
67.03'

A-87.29'
R-286.91'
D-17°25'53"
B-S 80°33'31" W
C-86.95'
T-43.98'


3"X6" POINTED
STONE FOUND
S 01°41'50" E
28.32'
S 01°41'50" E
35.77'

ALVANDO SAENZ
BARBARA SAENZ
O.R. 162-193

0.093 AC.

TO GO TO
ADJOINER

1330.28'
S 02°04'13" E

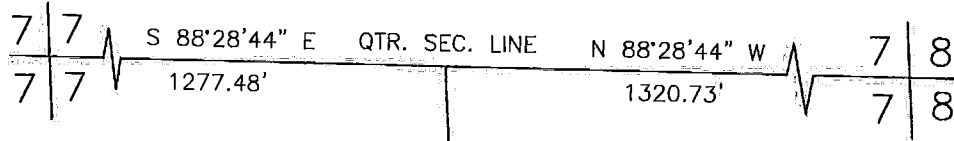

I CERTIFY THIS SURVEY TO BE CORRECT
TO THE BEST OF MY KNOWLEDGE.

AARON L. GERBER P.S. 8379

DATE: NOV. 14, 2019

ALG\CES

FILE NAME: WORK5\S-639-19\CNK



BAKER SURVEYING, LLC
138 N. CLAY STREET
MILLERSBURG, OHIO 44654
PH. 330-674-4788
EMAIL: bakersurveying@gmail.com