

THE COSHOCTON LAND SURVEYING SERVICE

133 S. FOURTH ST.


COSHOCTON, OHIO 43812

BEING PART OF: LOT ~
 SEC. 15
 QUAR. 2nd
 T8N, R8W U.S.M.L.
 TOWNSHIP Richland
 COUNTY Holmes

SURVEY FOR: Noah Gallion

DATE: July 1974

SCALE: 1" = 200'

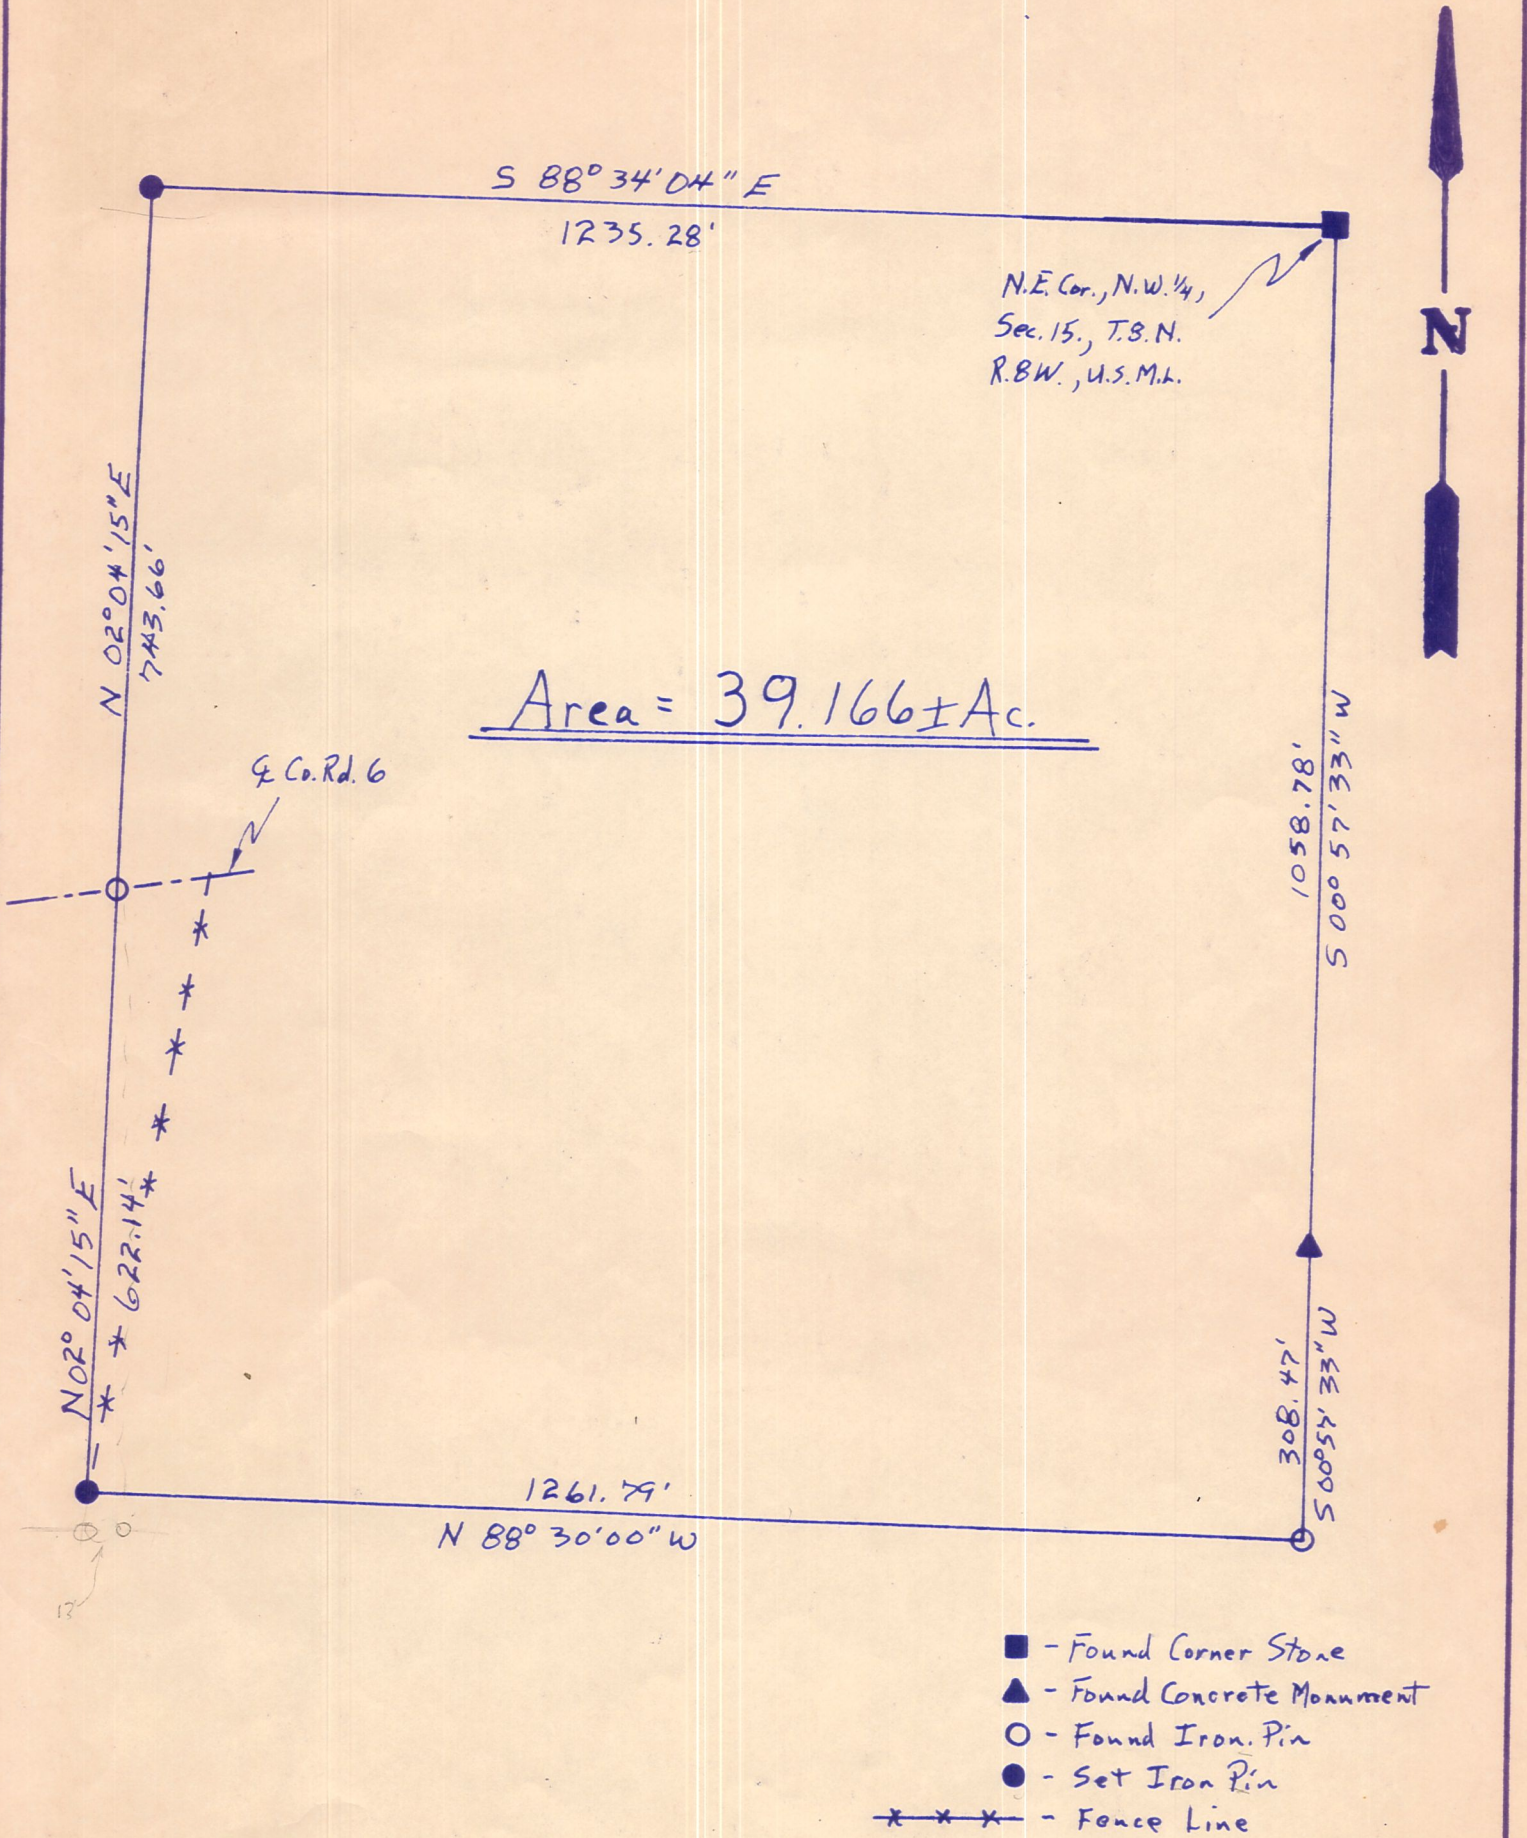

I hereby certify the above plat to be correct to the best of my knowledge and belief.

THE COSHOCTON LAND SURVEYING SERVICE

John E. ...
 REGISTERED SURVEYOR 5935