

S11, T8N, R9W

T.R. 34

I.P. set with rocks

I.P. set with rocks around it

45.35' I.P. set with rocks around it

45.35' I.P. set with rocks around it


396.37'

489.08' T.R. 34

59.80'

Stone monument found at S.W. crn'r S15, T8N, R8W

515, T8N, R8W

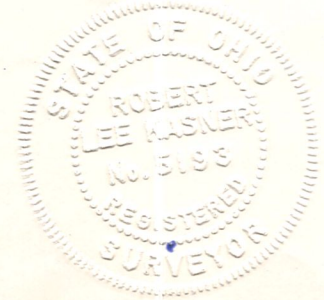


S.W. 1/4 S.W. 1/4 S15, T8N, R8W
54.4164 acres.
Tract 2 V213 P674

I.P. set with rocks around it

N87°22'43"W 1,798.68'

1,249.80'

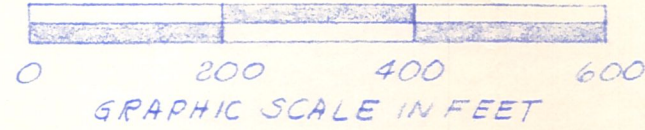

MAP OFFICE COPY

Stone monument found at N.W. crn'r S.E. 1/4 S.W. 1/4 S15, T8N, R8W

587°38'26"E 1,815.48'

N3°53'59"E 1,316.25'

3

Drill hole in rock at S.W. crn'r S.E. 1/4 S.W. 1/4 S15, T8N, R8W

N86°56'33"W 1,858.09'

S16, T8N, R8W

S.E. 1/4 S.W. 1/4 S15, T8N, R8W
55.6783 acres.
Tract 1 V213 P674

587°21'12"E 1,815.48'

52°18'42"W 1,529.24'

I.P. set with rocks around it at S.E. crn'r S.E. 1/4 S.W. 1/4 S15, T8N, R8W

I.P. set with rocks around it at N.E. crn'r S.E. 1/4 S.W. 1/4 S15, T8N, R8W in Spring seep.

PLAT OF A SURVEY
Known as the S.W. 1/4 &
S.E. 1/4 of S.W. 1/4 S15, T8N,
R8W of Richland Twp. Hol.
Co., Ohio.

Robert L. Kasner P.S. 5193
P.E. 28820
3/7/83

4412 214