
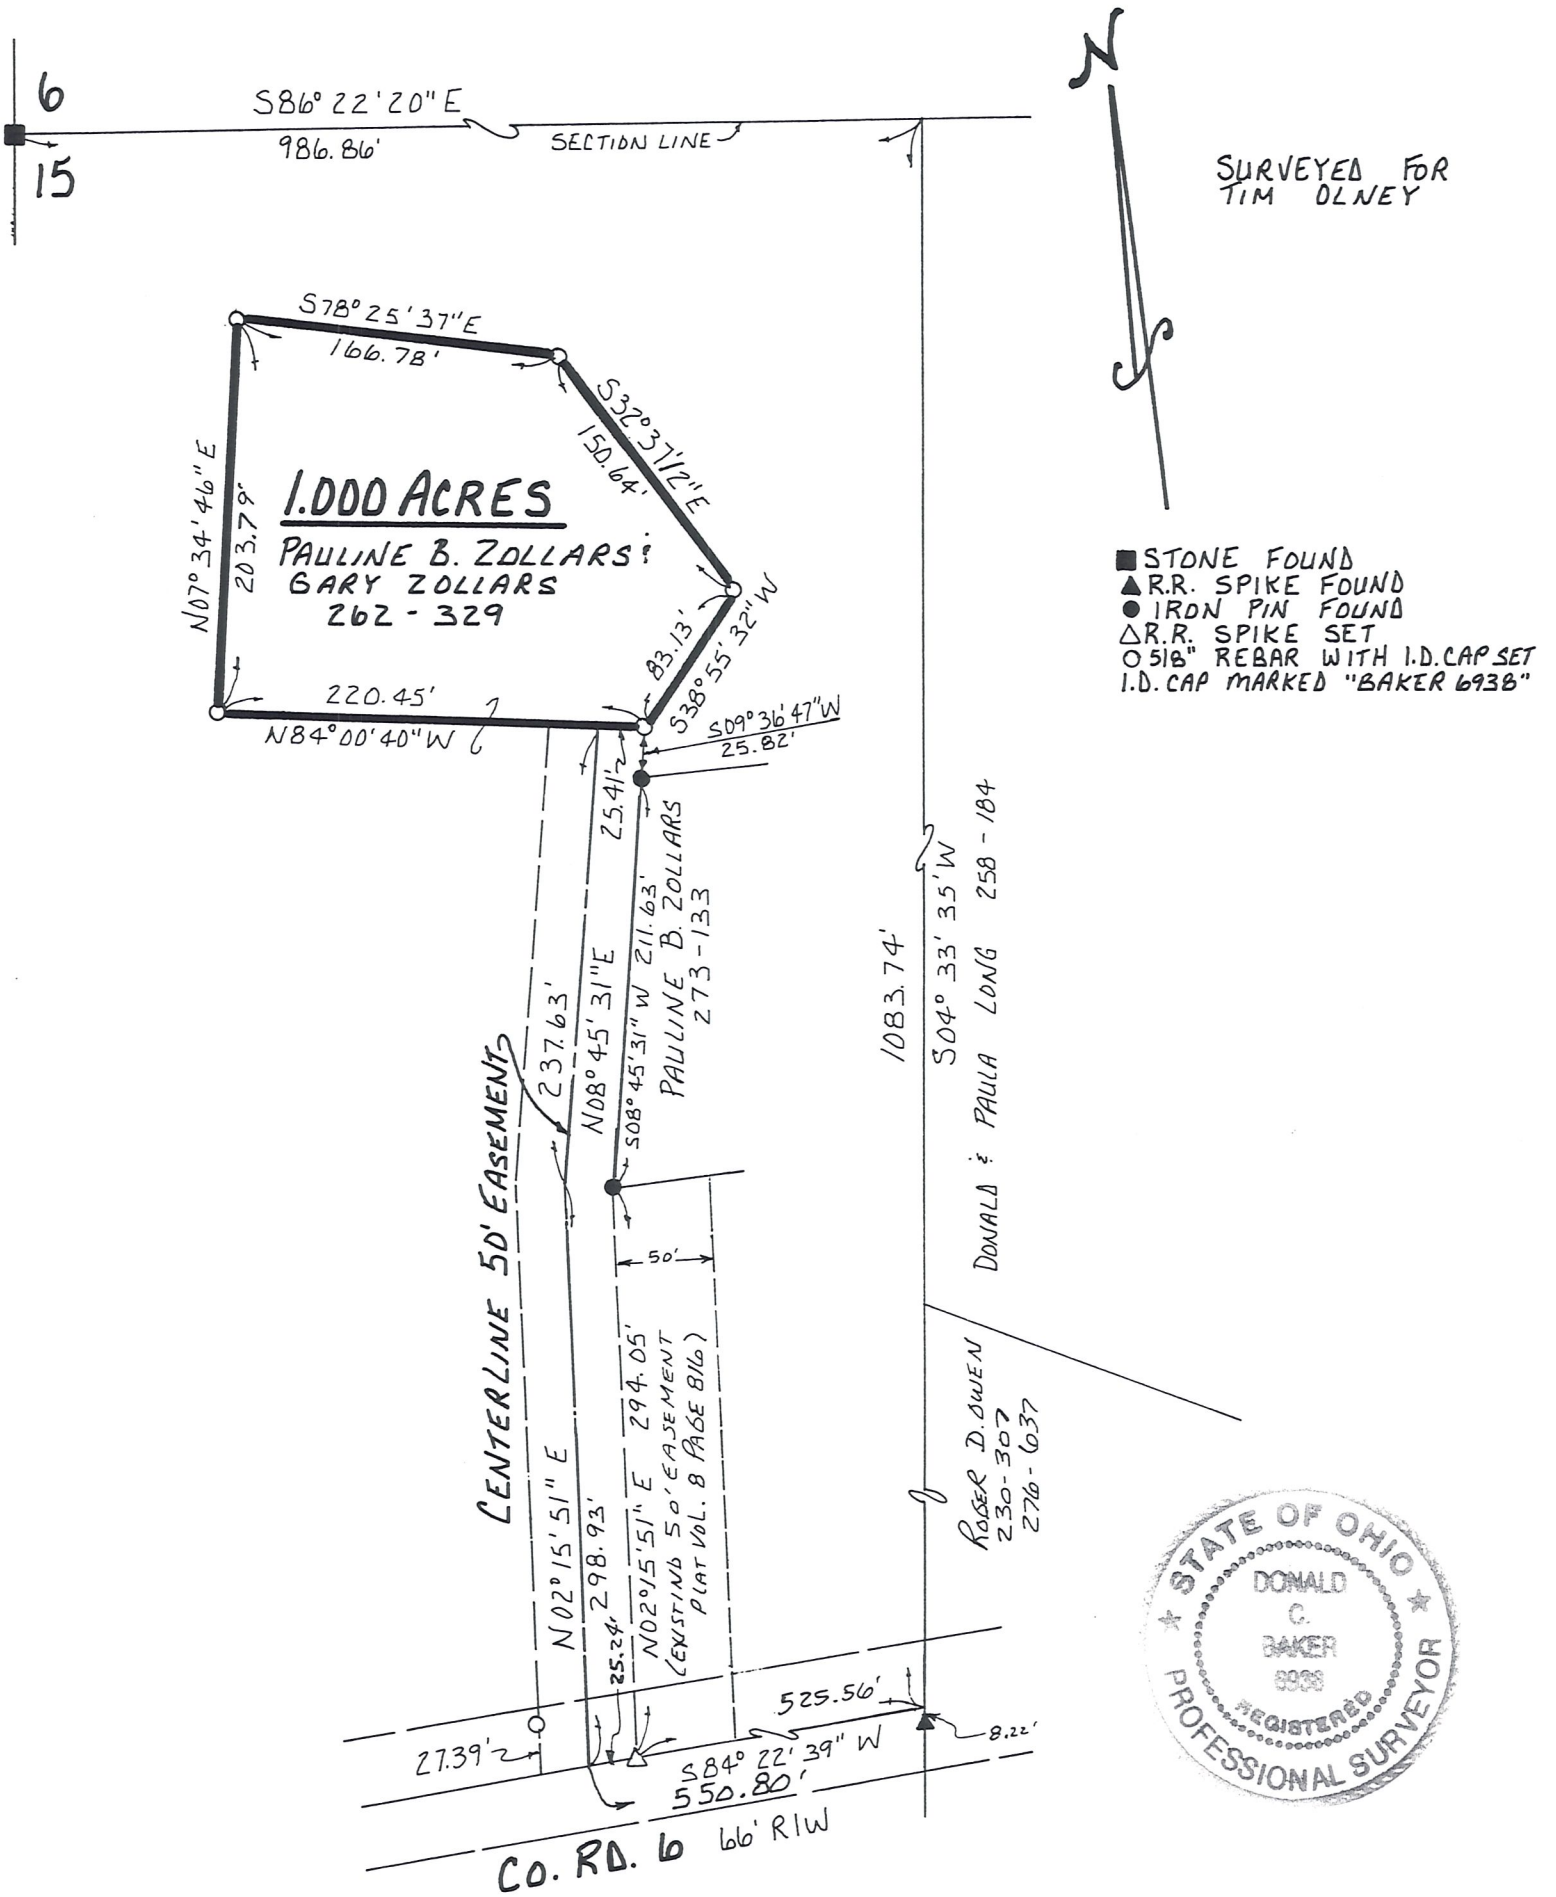


**REFERENCES:**

DEED VOL. 262 PAGE 329  
 " " 258 " 184  
 " " 273 " 133

BEARINGS FROM PLAT VOL. 14  
 PAGE 105

**RICHLAND TOWNSHIP  
 N.W. QTR. SECTION 15  
 T-8N; R-8W  
 HOLMES COUNTY, OHIO**

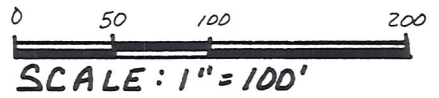

SURVEYED FOR  
 TIM OLNEY

- STONE FOUND
- ▲ R.R. SPIKE FOUND
- IRON PIN FOUND
- △ R.R. SPIKE SET
- 5/8" REBAR WITH I.D. CAP SET
- I.D. CAP MARKED "BAKER 6938"



I CERTIFY THIS SURVEY TO BE CORRECT  
 TO THE BEST OF MY KNOWLEDGE.

*Donald C. Baker*

**DONALD C. BAKER P.S. 6938**  
 138 N. CLAY ST.  
 MILLERSBURG, OHIO 44654  
 PH: (330) 674-4788

JUNE 9, 1997

ZB797 FJM  
 F.C.C. - F.D. BAKER