





RICHLAND TOWNSHIP
 HOLMES COUNTY, OHIO
 SE. Qtr., Sec. 1, T-8N, R-9W

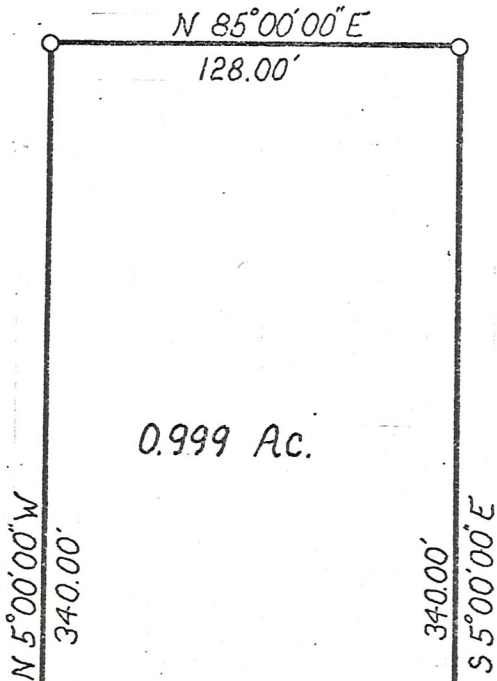

Nathan & Irene Miller
 Deed Vol. 197 Pg. 783

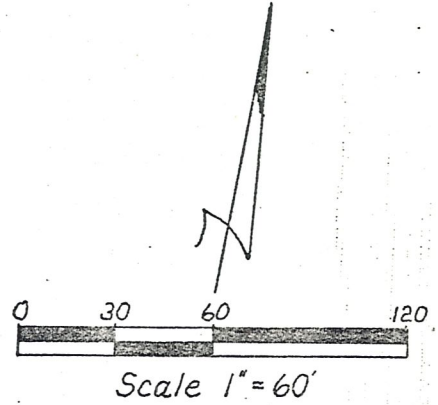

- Iron Pin Found
- Iron Pin Set (3/8 Rebar)

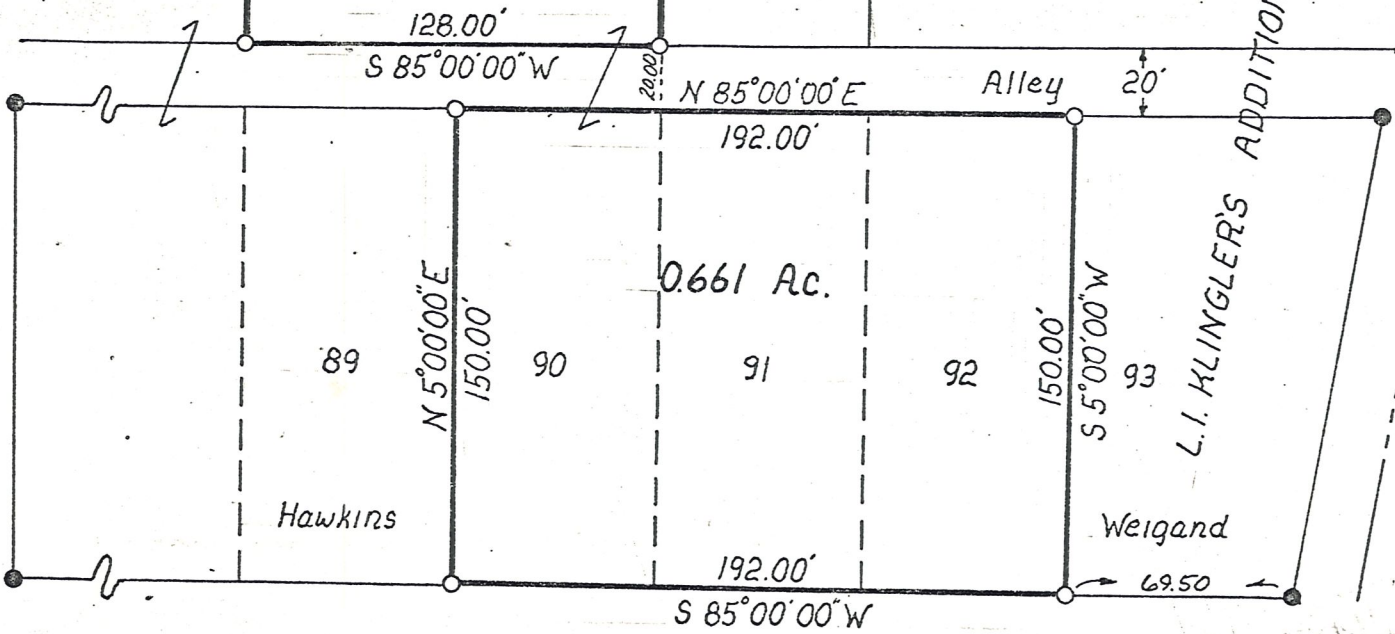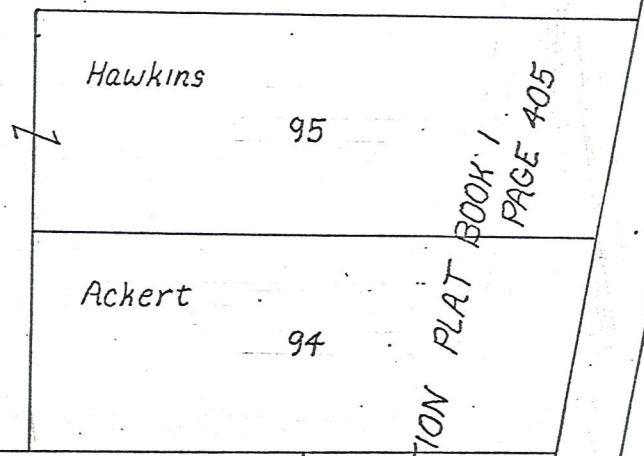

S.R. 520 Killbuck Road 60'

I Certify This Plat To be Correct
 To The Best of my Knowledge.

William H. Long June 15, 1982
 William H. Long R.S. 6505