
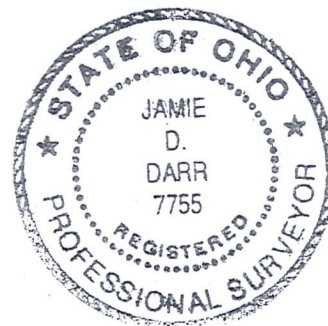


RICHLAND TOWNSHIP  
 S.E. & S.W. QTRS. SECTION 5  
 T-8 N; R-9 W  
 HOLMES COUNTY, OHIO

SURVEYED FOR: BOB MURRAY

REFERENCES:

- DEED VOL. 13 PAGE 143
- DEED VOL. 239 PAGE 670
- DEED VOL. 265 PAGES 229, 231 & 538
- DEED VOL. 280 PAGE 386
- O.R. VOL. 29 PAGE 752
- O.R. VOL. 147 PAGE 718
- PLAT VOL. 10 PAGE 811
- PLAT VOL. 14 PAGE 857
- PLAT VOL. 17 PAGE 294
- BEARINGS FROM PLAT VOL. 10 PAGE 811

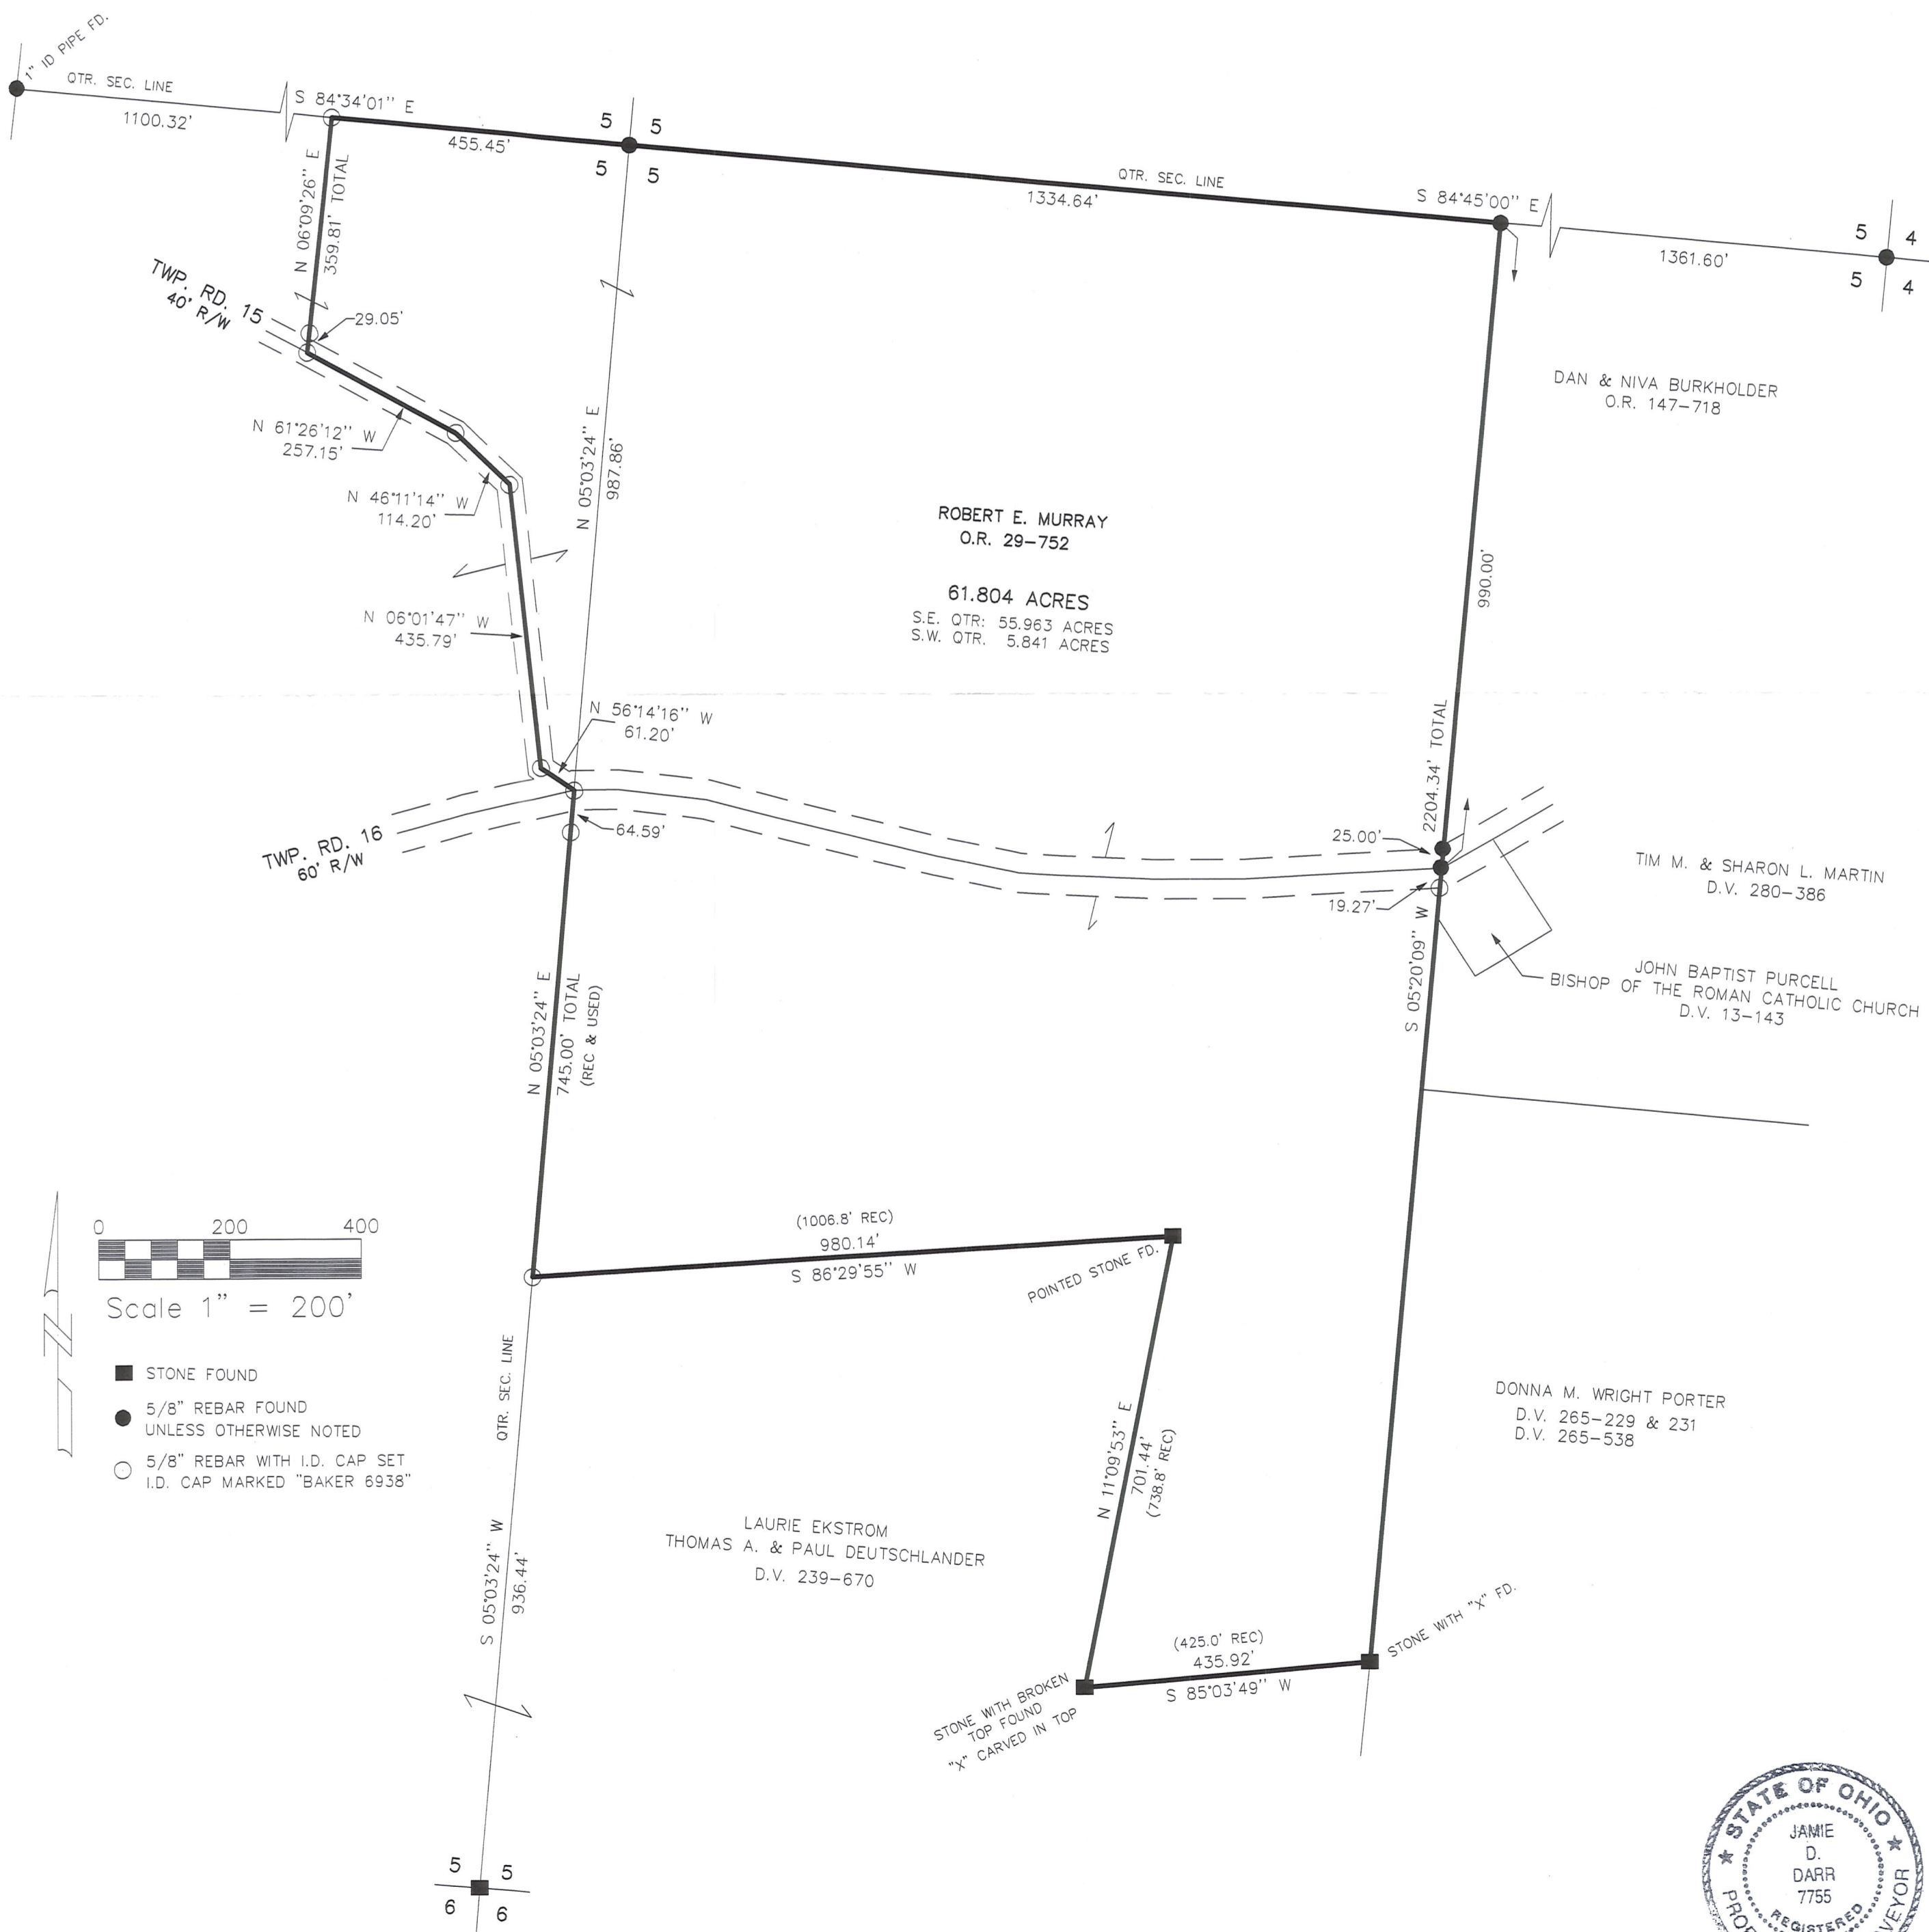

I CERTIFY THIS SURVEY TO BE CORRECT TO THE BEST OF MY KNOWLEDGE.

JAMIE D. DARR P.S. 7755  
 DATE: JULY 22, 2003

JDD/ FCC  
 File name: C:\JOBS1\S-549-03\ERZ

DONALD C. BAKER SURVEYING  
 138 N. CLAY ST.  
 MILLERSBURG, OHIO 44654  
 PH. 330-674-4788  
 FAX 330-674-6027