RICHLAND TOWNSHIP
HOLMES COUNTY, OHIO
SE Qtr., NE Qtr., Sec. 13, T-8N, R-9W

0 60 120
Scale In Feet 1" = 60'

△ Railroad Spike Set
○ Iron Pin Set - 5/8" Rebar With Yellow Cap Marked "LONG-6505"

References:
Deed Vol. 223, Pg 209
Road Book 2, Pg. 45 & 46
" " 4, Pg. 159 & 160

Surveyed For Lloyd Schlaugh
Sept. 18, 1986

Bearings Assumed

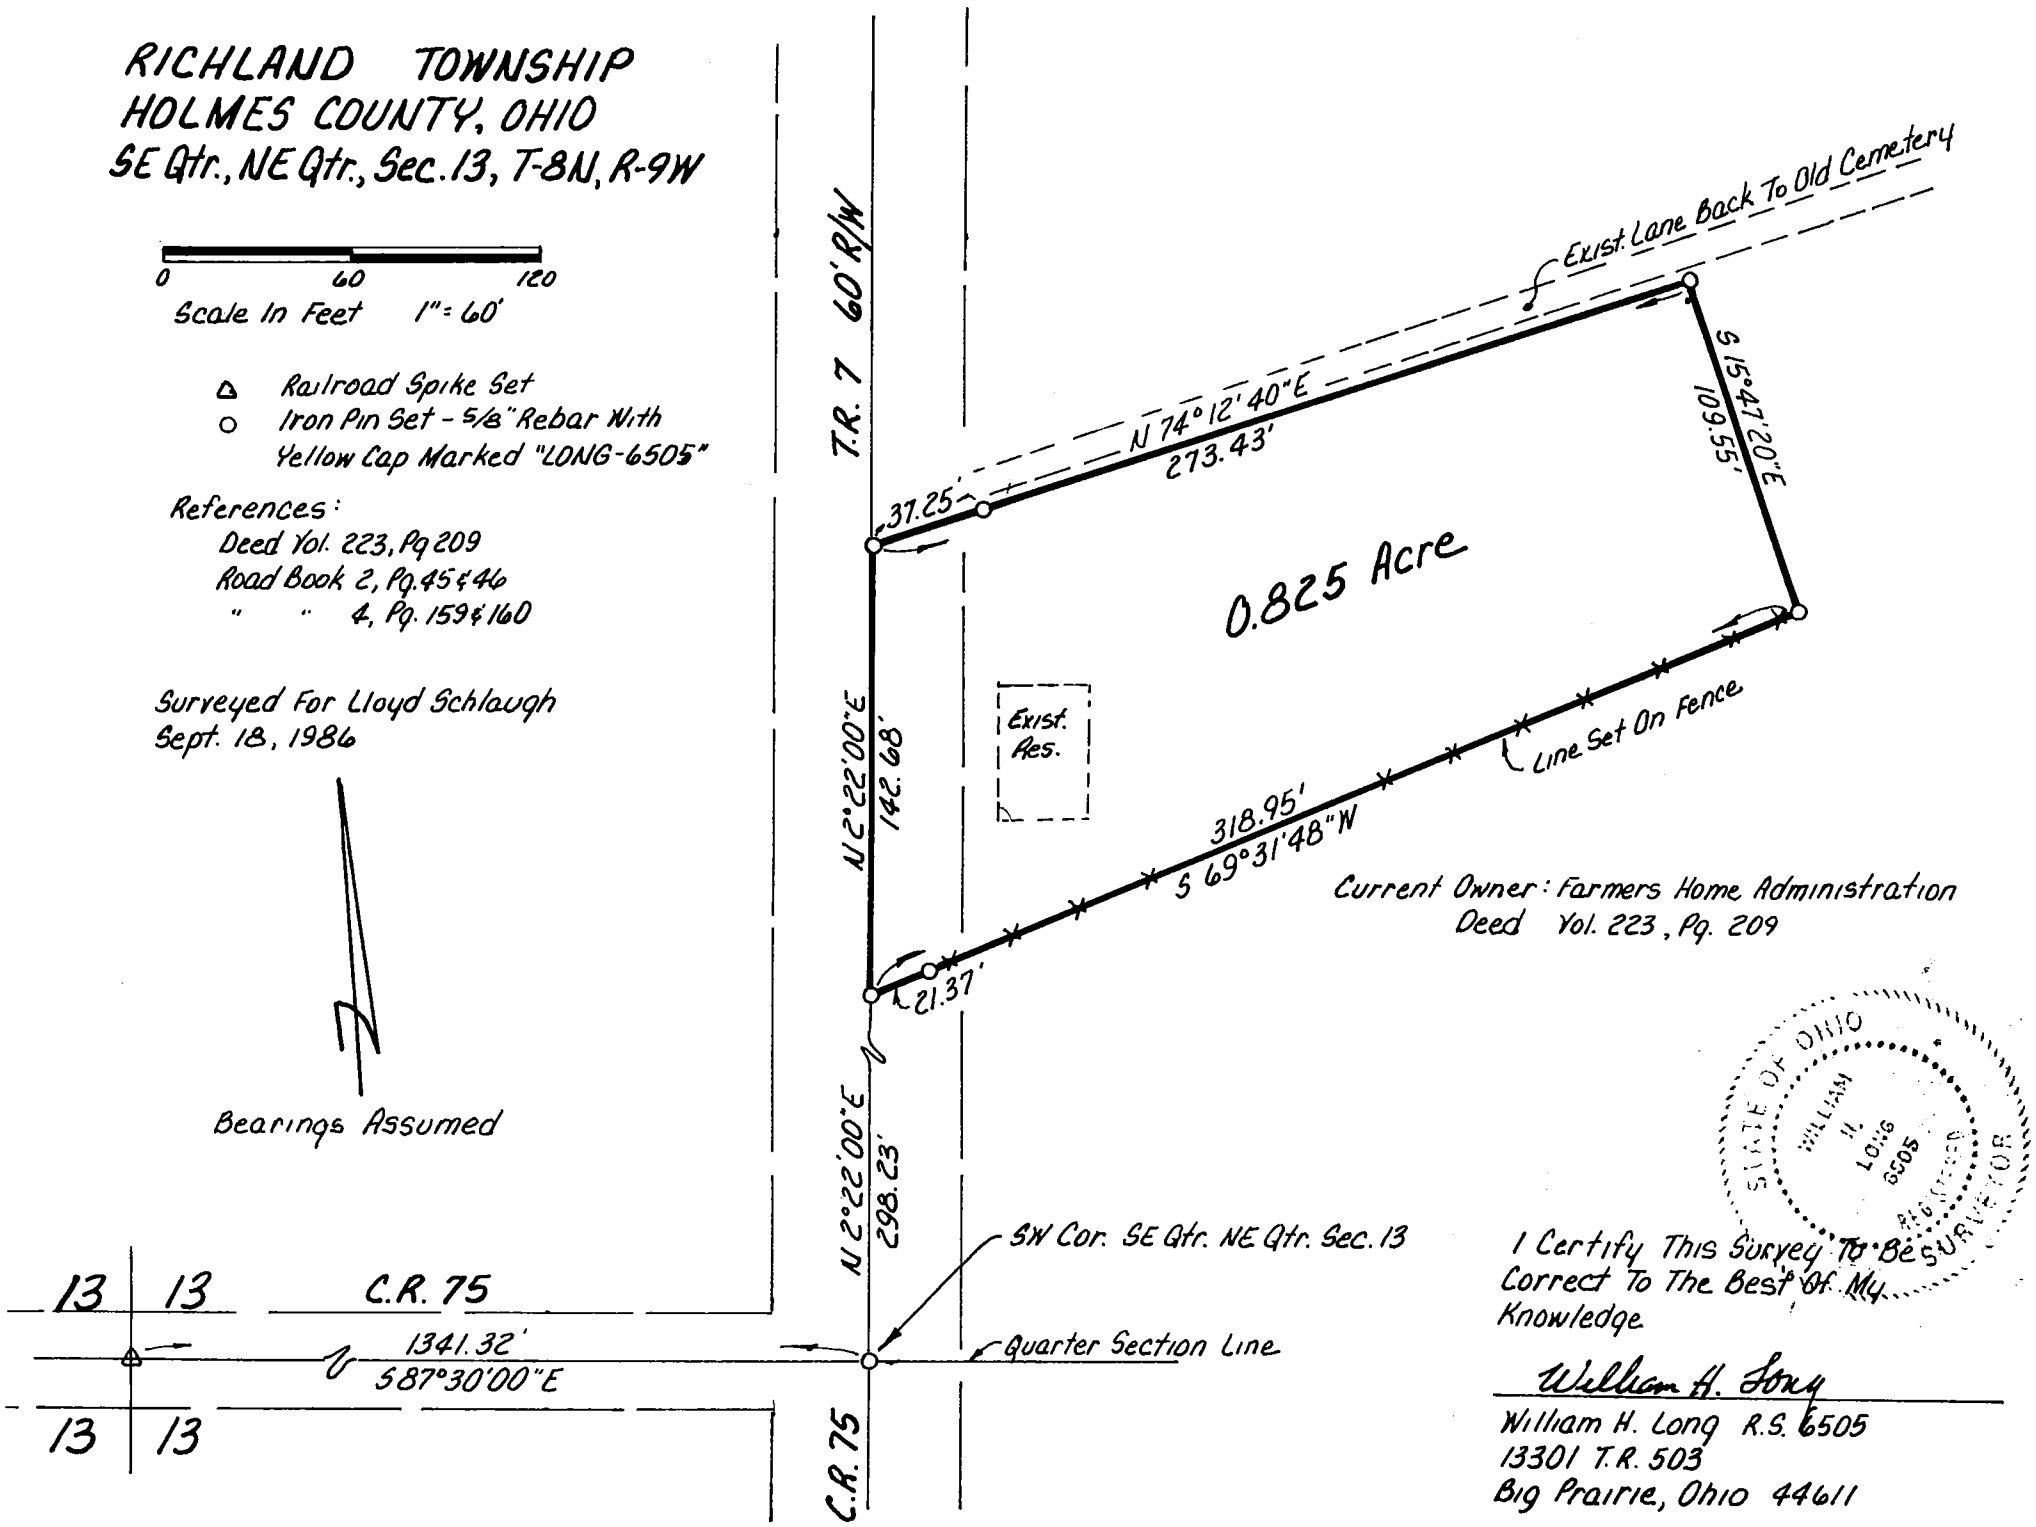

Current Owner: Farmers Home Administration
Deed Vol. 223, Pg. 209

STATE OF OHIO WILLIAM H. LONG 6505 REGISTERED SURVEYOR

I Certify This Survey To Be Correct To The Best Of My Knowledge

William H. Long

William H. Long R.S. 6505
13301 T.R. 503
Big Prairie, Ohio 44611