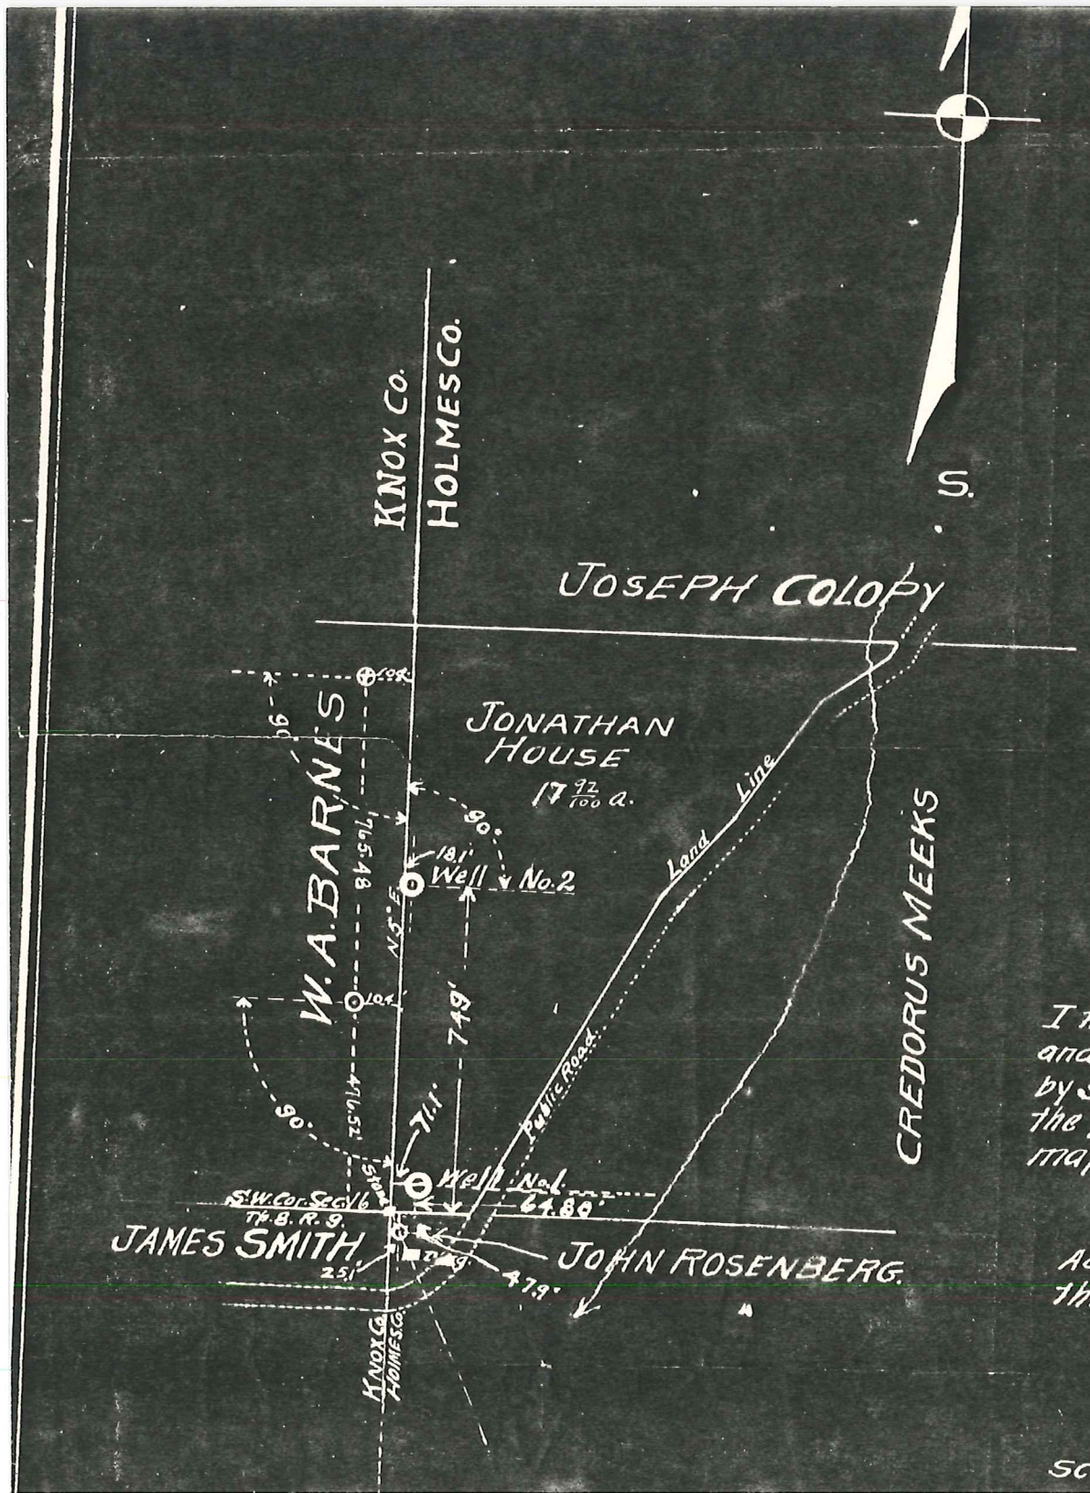

MAP

OF THE

JONATHAN HOUSE FARM

Located in

RICHLAND TOWNSHIP, HOLMES COUNTY, OHIO.

AND IS THE SOUTH-WEST PART OF THE SOUTH WEST QUARTER OF SECTION 16 Township 8, in Range 9.

Showing Location of Oil Wells drilled by

N.L.C. KACHALMACHER, of Logan, Ohio.

Surveyed Oct. 21st 1916 by W.L. Reidenbach C.E.

CERTIFICATE OF ENGINEER

I the undersigned hereby certify, that this map is true and correct and shows all the information required by Section 973 of the General Code of Ohio and covers the period ending October 21st 1916 as surveyed and mapped by me

W.L. Reidenbach C.E.

Acknowledged before me a Clerk of Courts this 4th day of November 1916.

E.A. Shaus

Clerk of Court

Scale 400 feet = 1 inch.