
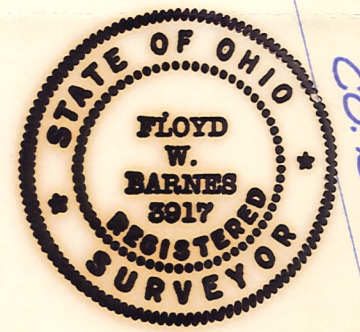
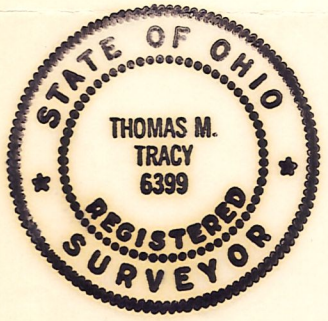


PART OF THE S.E. QTR. OF SECT. 25,
T8. R9, RICHLAND TWP., HOLMES CO., O.

SCALE: 1" = 80 FT.

- - IRON PIN SET
- - IRON PIPE FOUND
- △ - RAILROAD SPIKE SET
- ▲ - RAILROAD SPIKE FOUND

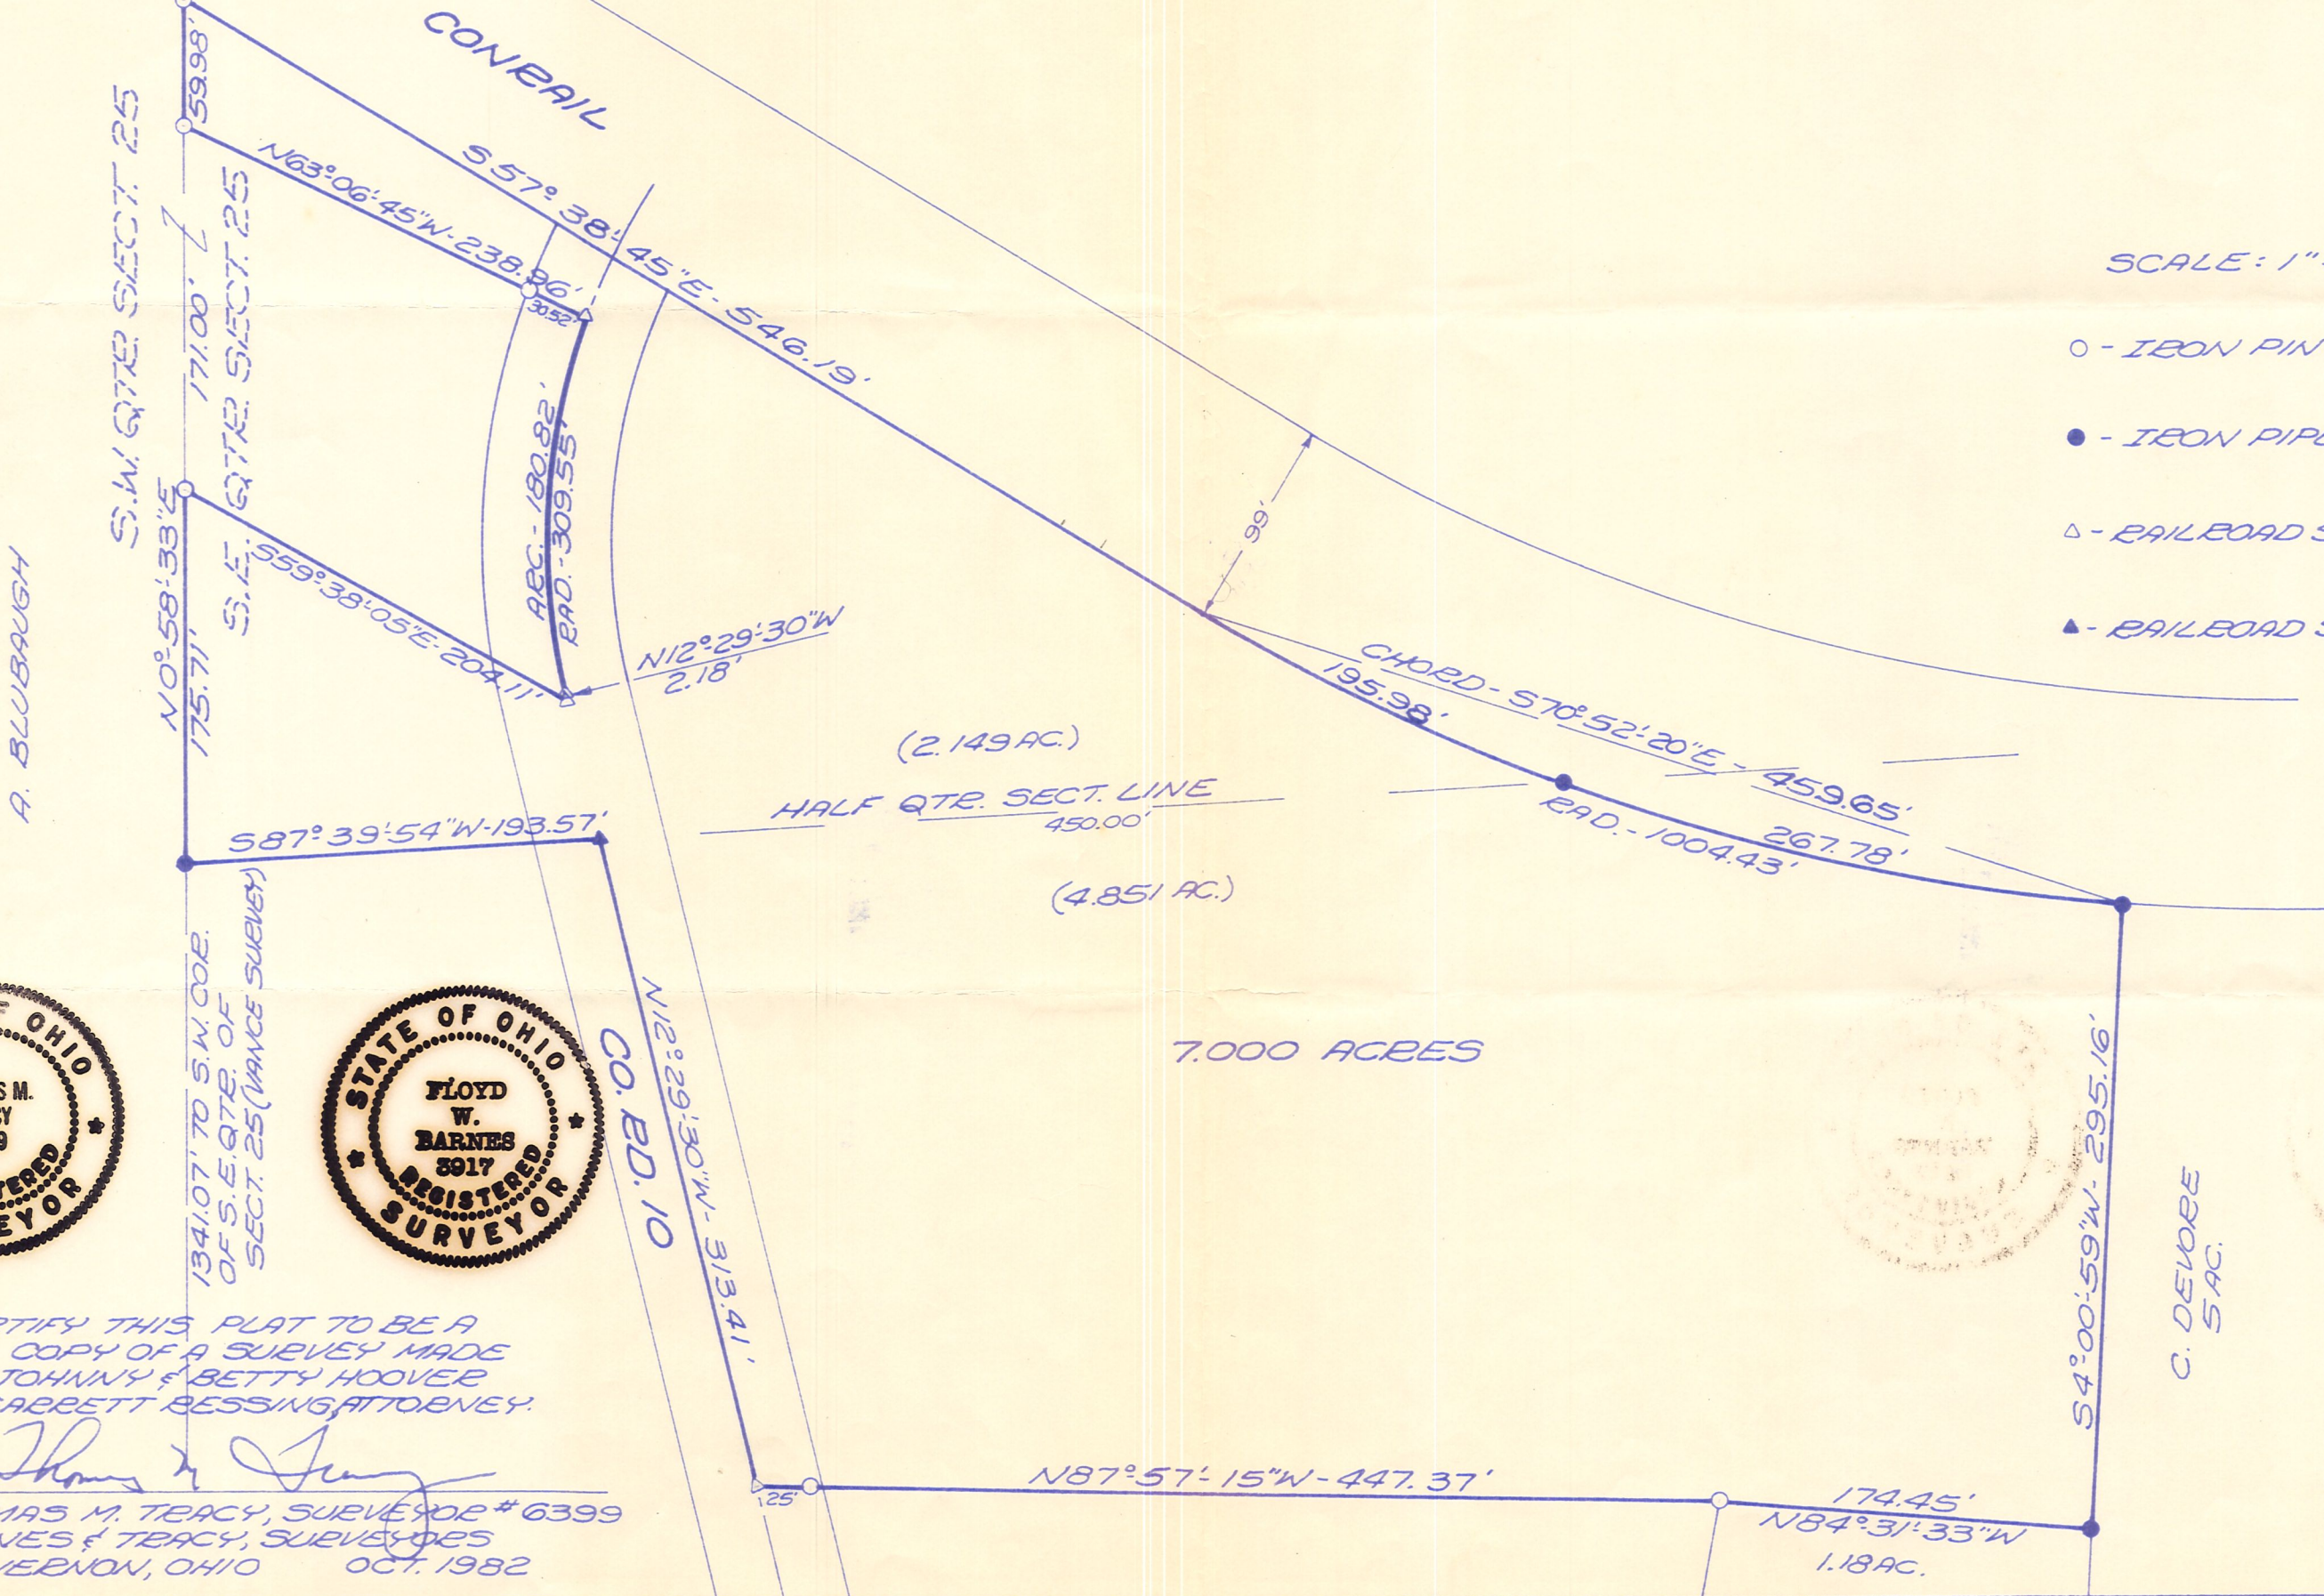

I CERTIFY THIS PLAT TO BE A TRUE COPY OF A SURVEY MADE FOR JOHNNY & BETTY HOOVER AND GARRETT BESSING ATTORNEY.

Thomas M. Tracy
 THOMAS M. TRACY, SURVEYOR # 6399
 BARNES & TRACY, SURVEYORS
 MT. VERNON, OHIO OCT. 1982

VANCE SURVEY - 7-81