

MAY 24 '05 PM 3:27

SEWER EASEMENT SURVEY
RICHLAND TOWNSHIP
S.E. QTR. SECTION 25
T-8 N; R-9 W
HOLMES COUNTY, OHIO

SURVEYED FOR: JOHANNES SCHLABACH

REFERENCES:

O.R. VOL 167 PAGE 686

O.R. 178 PAGE 1267

PLAT VOL. 11 PAGE 83

BEARINGS FROM PLAT VOL. 11 PAGE 83




I CERTIFY THIS SURVEY TO BE CORRECT
TO THE BEST OF MY KNOWLEDGE.

Donald C. Baker
DONALD C. BAKER PS 6938

DATE: MAY 17, 2005

FCC\DCB

File Name: C:\WORK\S-317-05\ERZ

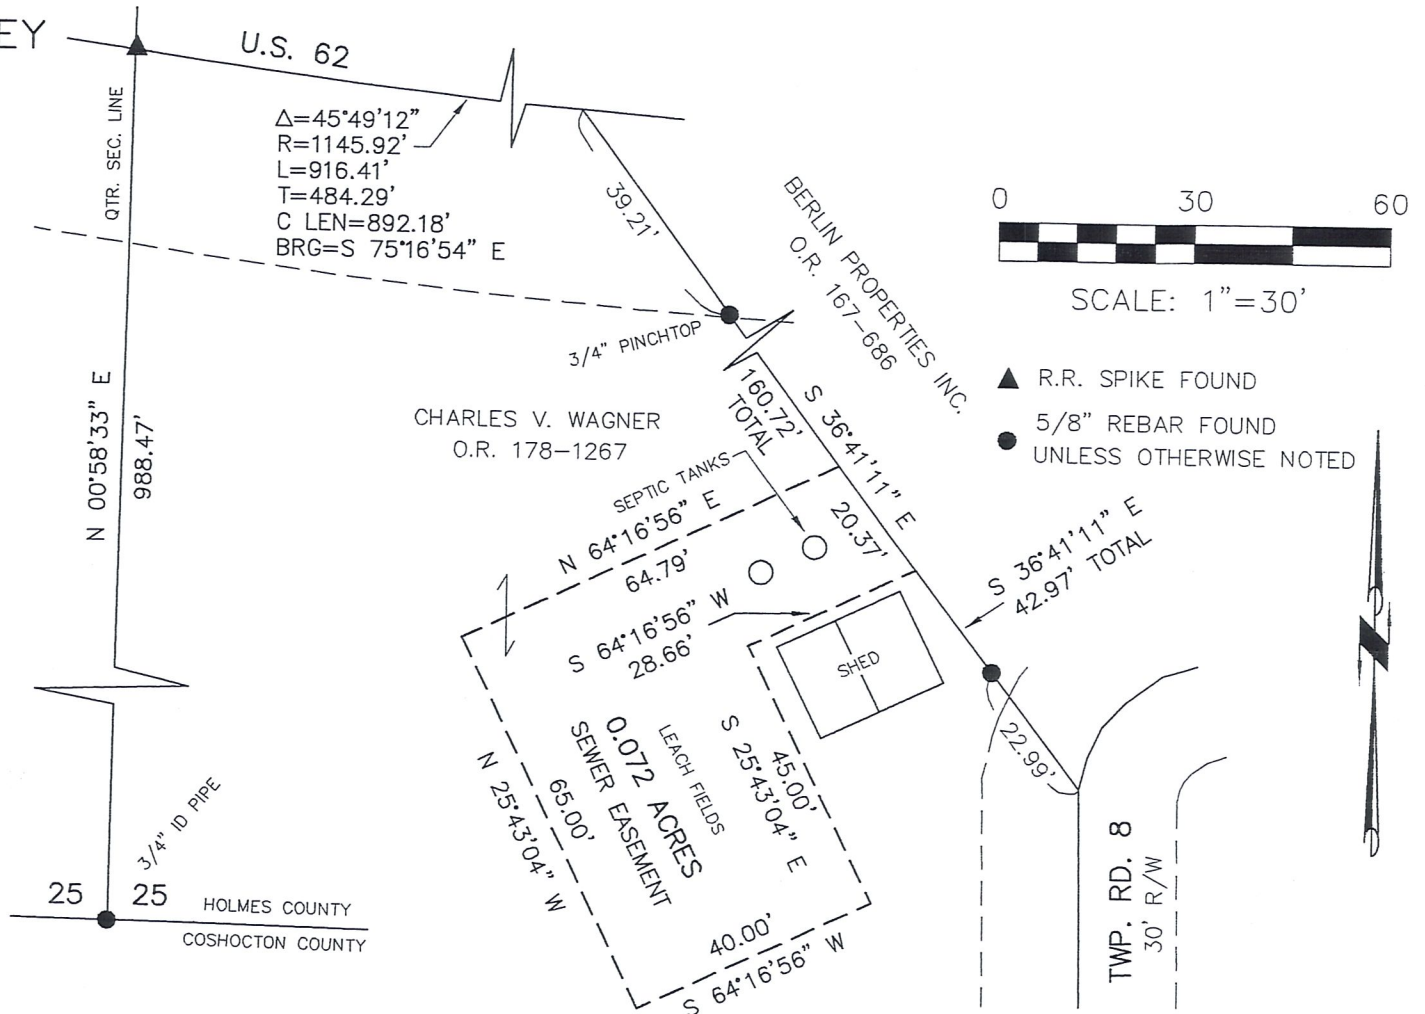

DONALD C. BAKER SURVEYING
138 N. CLAY ST.
MILLERSBURG, OH 44654
PH. 330-674-4788
FAX: 330-674-6027