


RIPLEY TWP.
S.W. QTR. SEC. 3
T-17 R-14
HOLMES CO., OHIO

SCALE: 1" = 100'

● = I.P. FD.
○ = I.P. SET

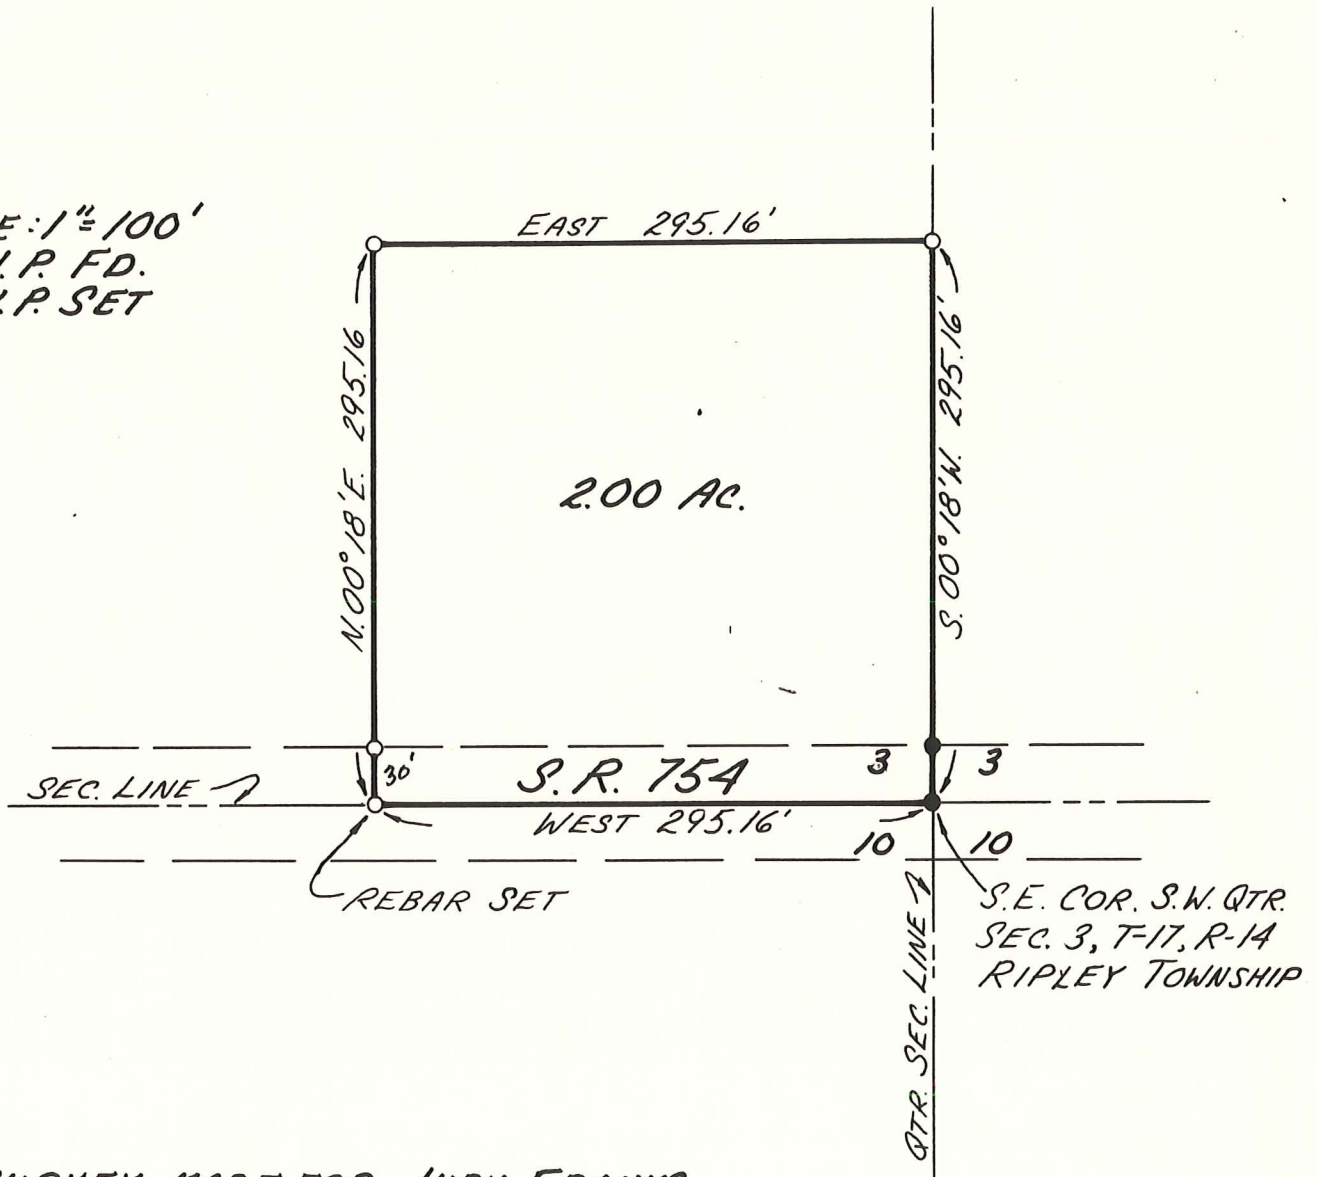

SURVEY MADE FOR JUDY FRANKS

SW - 1878

SHAFFER, JOHNSTON,
LICHTENWALTER & ASSOCIATES, INC.
WOOSTER OHIO

STATE OF OHIO
REGISTERED SURVEYOR
RICHARD J. McDAID
R.S. 5009
THIS SURVEY AND PLAT TO
RECORD TO THE BEST OF MY KNOW-
LEDGE
M. C. DAID
5009
REGISTERED SURVEYOR
MARCH 1978
Richard J. McDaid
RICHARD J. McDAID R.S. 5009