


RIPLEY TOWNSHIP
S.E. QTR. SECTION 3
T-17 N; R-14 W
HOLMES COUNTY, OHIO


SURVEYED FOR: GARY and JAMES LEADBETTER

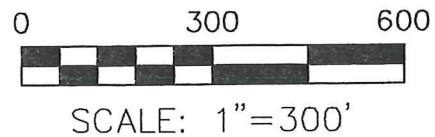

- STONE FOUND
- ▲ R.R. SPIKE FOUND
- 5/8" REBAR FOUND
UNLESS OTHERWISE NOTED
- 5/8" REBAR SET WITH I.D. CAP
I.D. CAP MARKED "BAKER 6938"


REFERENCES

DEED VOL. 275 PAGE 514
 DEED VOL. 251 PAGE 815
 O.R. VOL. 160 PAGE 317
 O.R. VOL. 232 PAGE 1725
 PLAT VOL. 16 PAGE 241
 BEARINGS FROM PLAT VOL. 16 PAGE 240

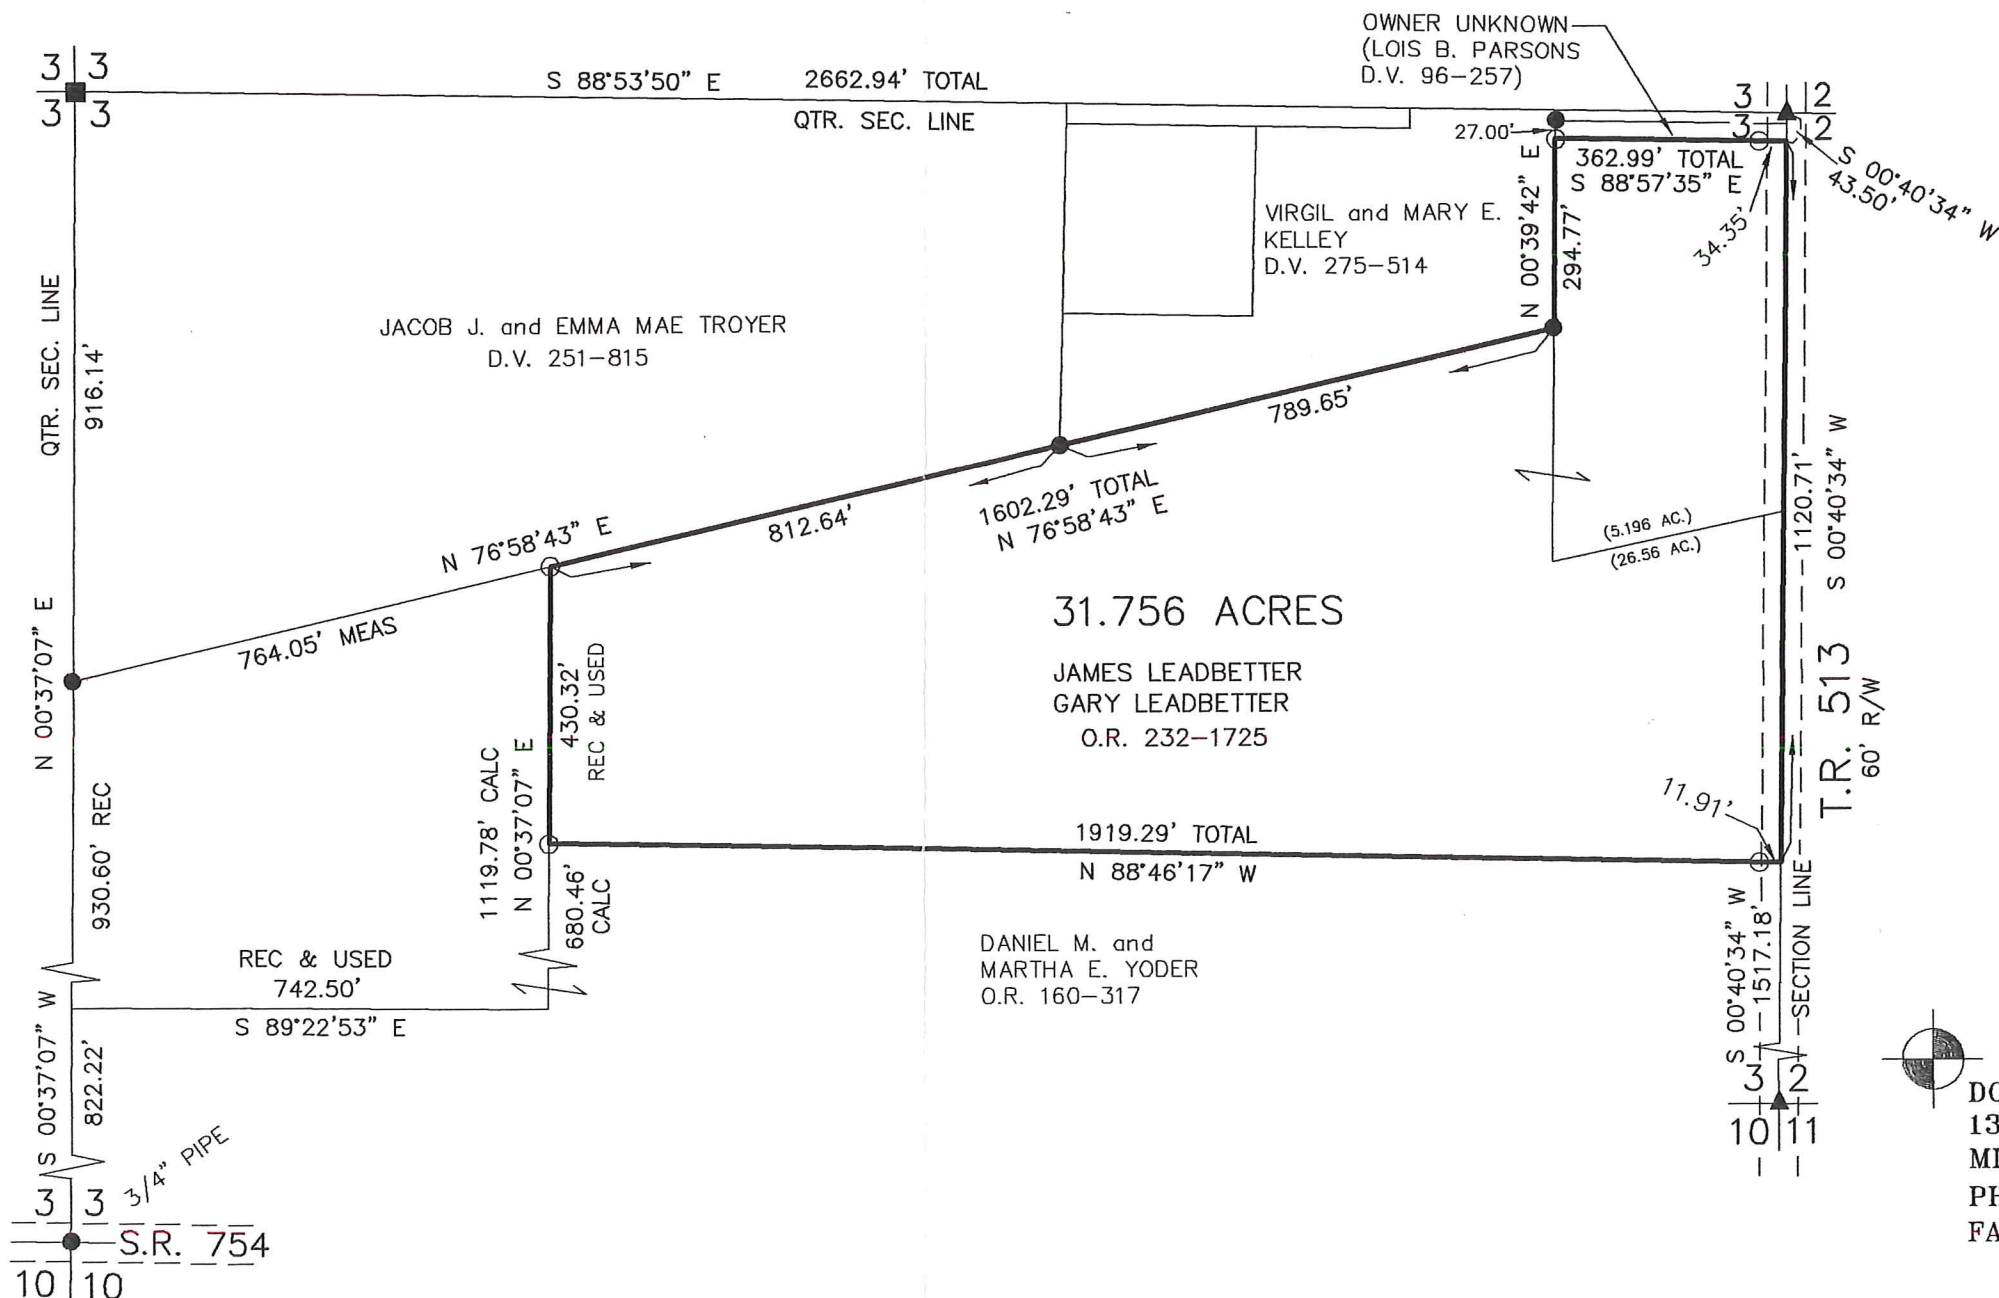

I CERTIFY THIS SURVEY TO BE CORRECT TO THE BEST OF MY KNOWLEDGE.

DONALD C. BAKER P.S. 6938
 DATE: JUNE 14, 2012
 FDB\CJC
 FILE NAME: WORK4\S-217A-12\DB-MD

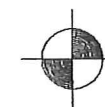

DONALD C. BAKER SURVEYING
 138 N. CLAY STREET
 MILLERSBURG, OHIO 44654
 PH. 330-674-4788
 FAX 330-674-6027