

RIPLEY TOWNSHIP  
 S. E. QTR. SECTION 5  
 T- 17N ; R- 14W  
 HOLMES COUNTY, OHIO

0 50 100 200




SCALE: 1"=100'

- ▲ R.R. SPIKE FOUND
- IRON PIN FOUND
- 5/8" RE BAR WITH I.D. CAP SET
- I.D. CAP MARKED "BAKER 6938"

REFERENCES:

- PLAT VOL. 3 PAGE 578
- PLAT VOL. 12 PAGE 89
- DEED VOL. 190 PAGE 801
- DEED VOL. 255 PAGE 1016
- PLAT VOL. 7 PAGE 454
- PLAT VOL. 12 PAGE 970
- PLAT VOL. 14 PAGE 263
- DEED VOL. 260 PAGE 925

BEARINGS FROM PLAT VOL. 12 PAGE 970

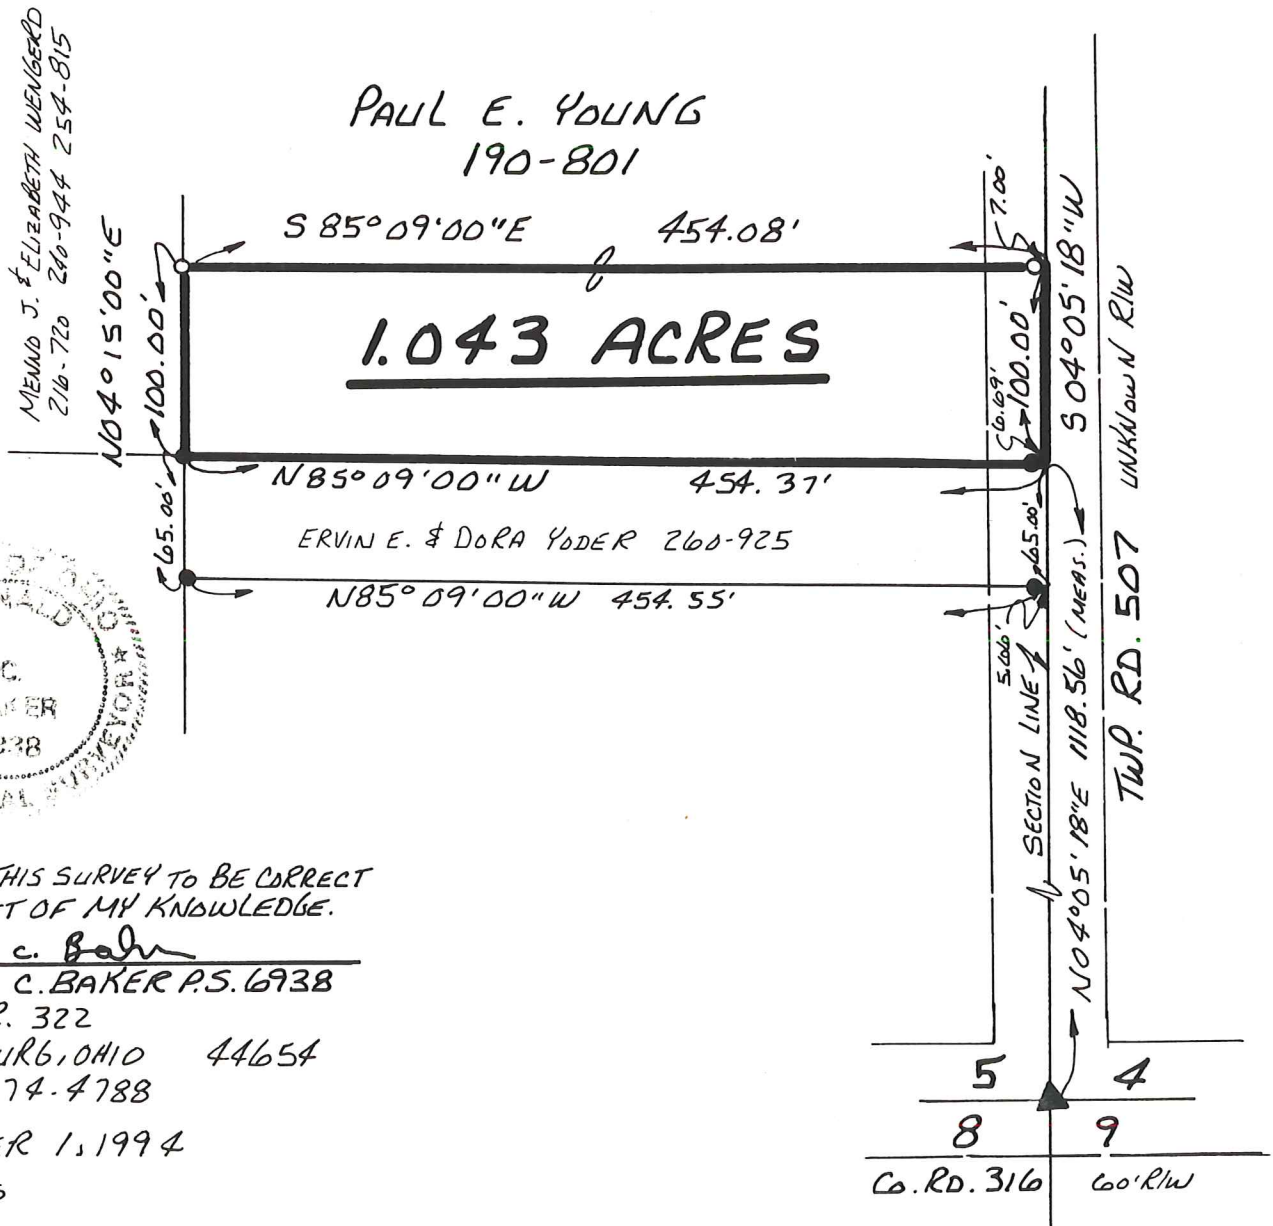

I CERTIFY THIS SURVEY TO BE CORRECT TO THE BEST OF MY KNOWLEDGE.

Donald C. Baker  
 DONALD C. BAKER P.S. 6938  
 5958 T.R. 322  
 MILLERSBURG, OHIO 44654  
 PH. (216) 674-4788  
 NOVEMBER 1, 1994  
 59894-MLS

