


0 50 100 200

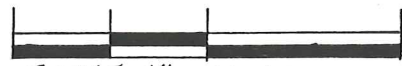


SCALE: 1" = 100'

- IRON PIN FOUND
- 5/8" REBAR WITH I.D. CAP SET
- I.D. CAP MARKED "BAKER 6938"

RIPLEY TOWNSHIP  
 S.W. QTR. SECTION 6  
 T-17 N; R-14 W  
 HOLMES COUNTY, OHIO  
 (SURVEYED FOR: JAMES MANSON)


REFERENCES:  
 DEED VOL. 257 PAGE 437  
 " " 176 " 525  
 " " 205 " 309  
 O.R. VOL. 63 PAGE 595  
 BEARINGS FROM PLAT VOL. 8  
 PAGE 490

RECEIVED  
 MAR 19 2001  
 Hol. Co. Tax Map Office

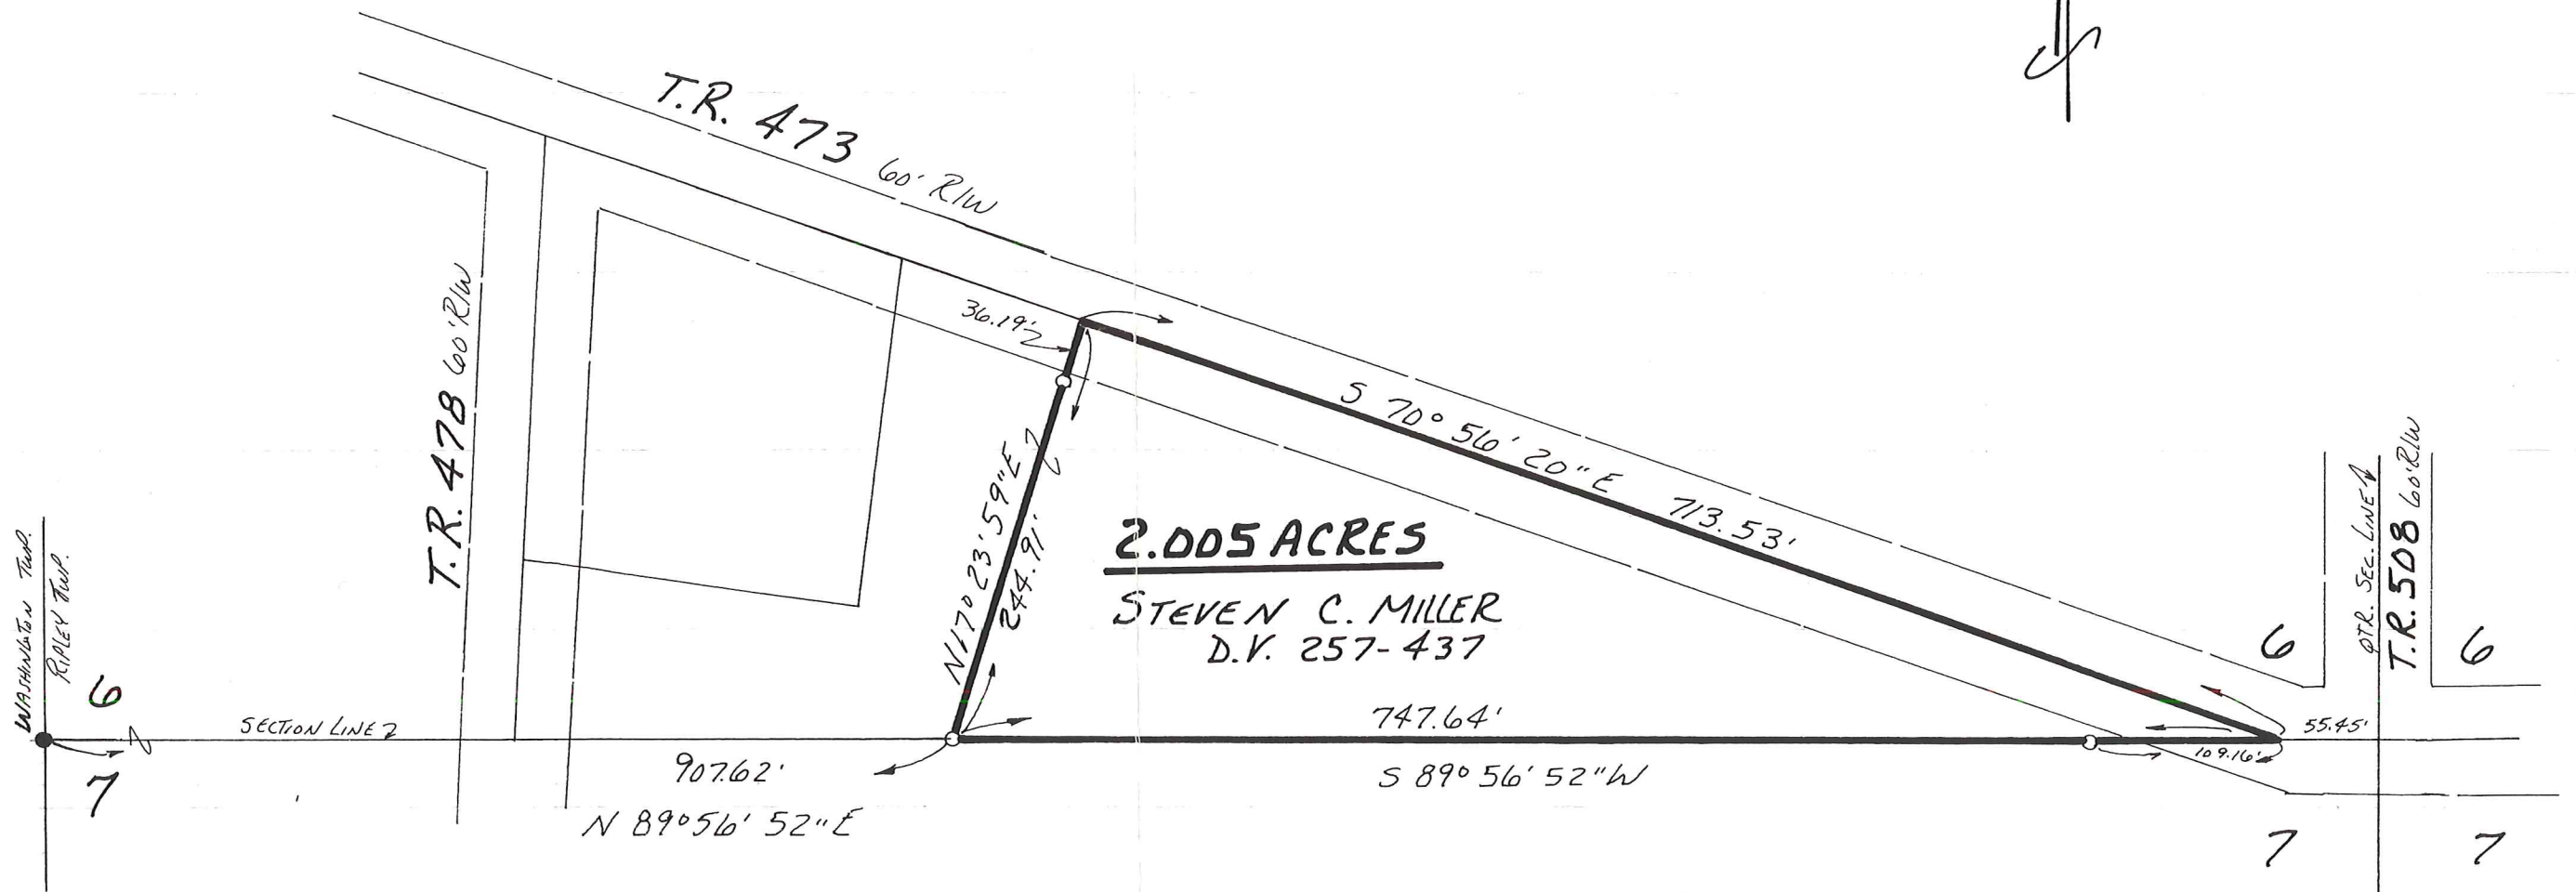

I CERTIFY THIS SURVEY TO BE CORRECT  
 TO THE BEST OF MY KNOWLEDGE.

*Jamie D. Darr*  
 JAMIE D. DARR P.S. 7755  
 DONALD C. BAKER SURVEYING  
 138 N. CLAY ST.  
 MILLERSBURG, OHIO 44654  
 PH. 330-674-4788  
 MARCH 16, 2001

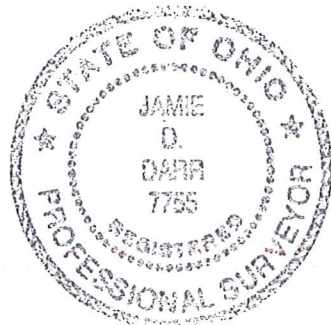

#21301 - M.L. DAVIS  
 F.C.C. - J.D. DARR