

# THE COSHOCTON LAND SURVEYING SERVICE

233 S. FOURTH ST.


COSHOCTON, OHIO 43812

BEING PART OF: LOT ~  
 SEC. 8  
 QUAR. 2<sup>nd</sup>  
 T17N, R14W, Congress Lands North of the Old Seven Ranges  
 TOWNSHIP Ripley  
 COUNTY Holmes

SURVEY FOR: Luther C. Hothem  
 DATE: July 1974  
 SCALE: 1" = 200'



● - Iron Pin

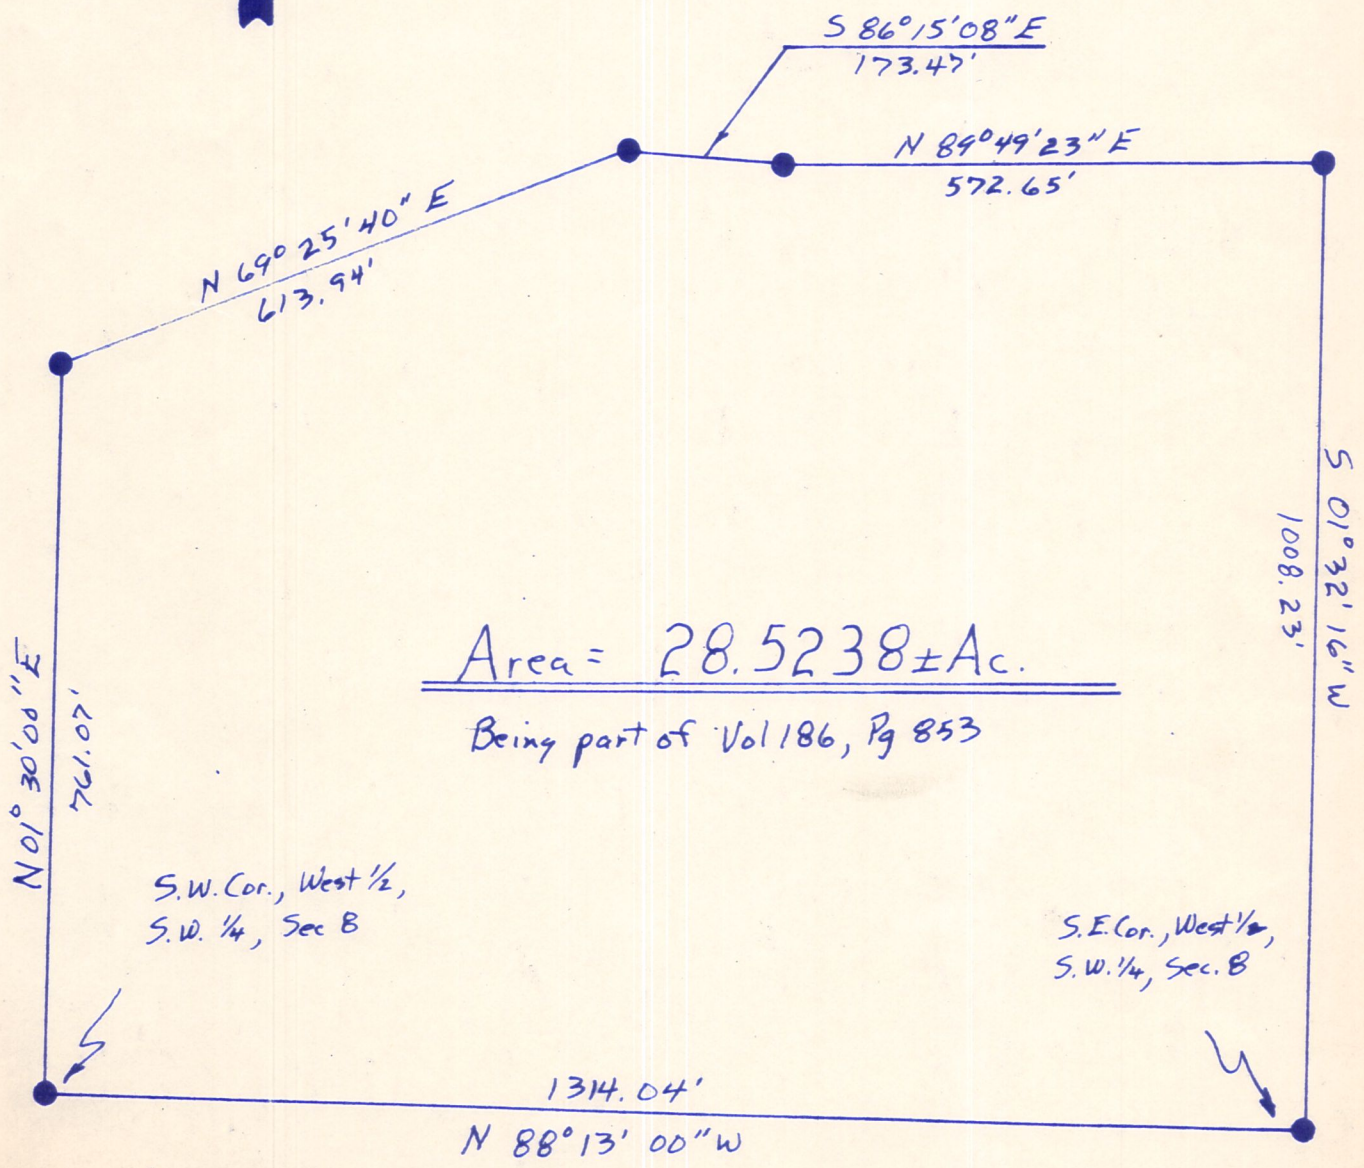

Area = 28.5238 ± Ac.

Being part of Vol 186, Pg 853

S.W. Cor., West 1/2,  
 S.W. 1/4, Sec 8

S.E. Cor., West 1/2,  
 S.W. 1/4, Sec. 8

I hereby certify the above plat to be correct to the best of my knowledge and belief.

THE COSHOCTON LAND SURVEYING SERVICE

*Jim [Signature]*  
 REGISTERED SURVEYOR ~ 5735