

BEING PART OF: LOT ~
 SEC. B
 QUAR.
 T12 N. R14 W., Congress Lands North of the Old Seven Ranges
 TWP. RIPLEY
 COUNTY HOLMES


THE COSHOCTON LAND SURVEYING SERVICE
 233 S. FOURTH ST. COSHOCTON, OHIO 43812
 PHONE: 614-622-4545

SURVEY FOR: Luther Hothorn

DATE: Sept. 1974

SCALE: 1" = 200'

Tract #1 Revised Sept. 27, 1974
 Tract #3 Added Sept. 30, 1974

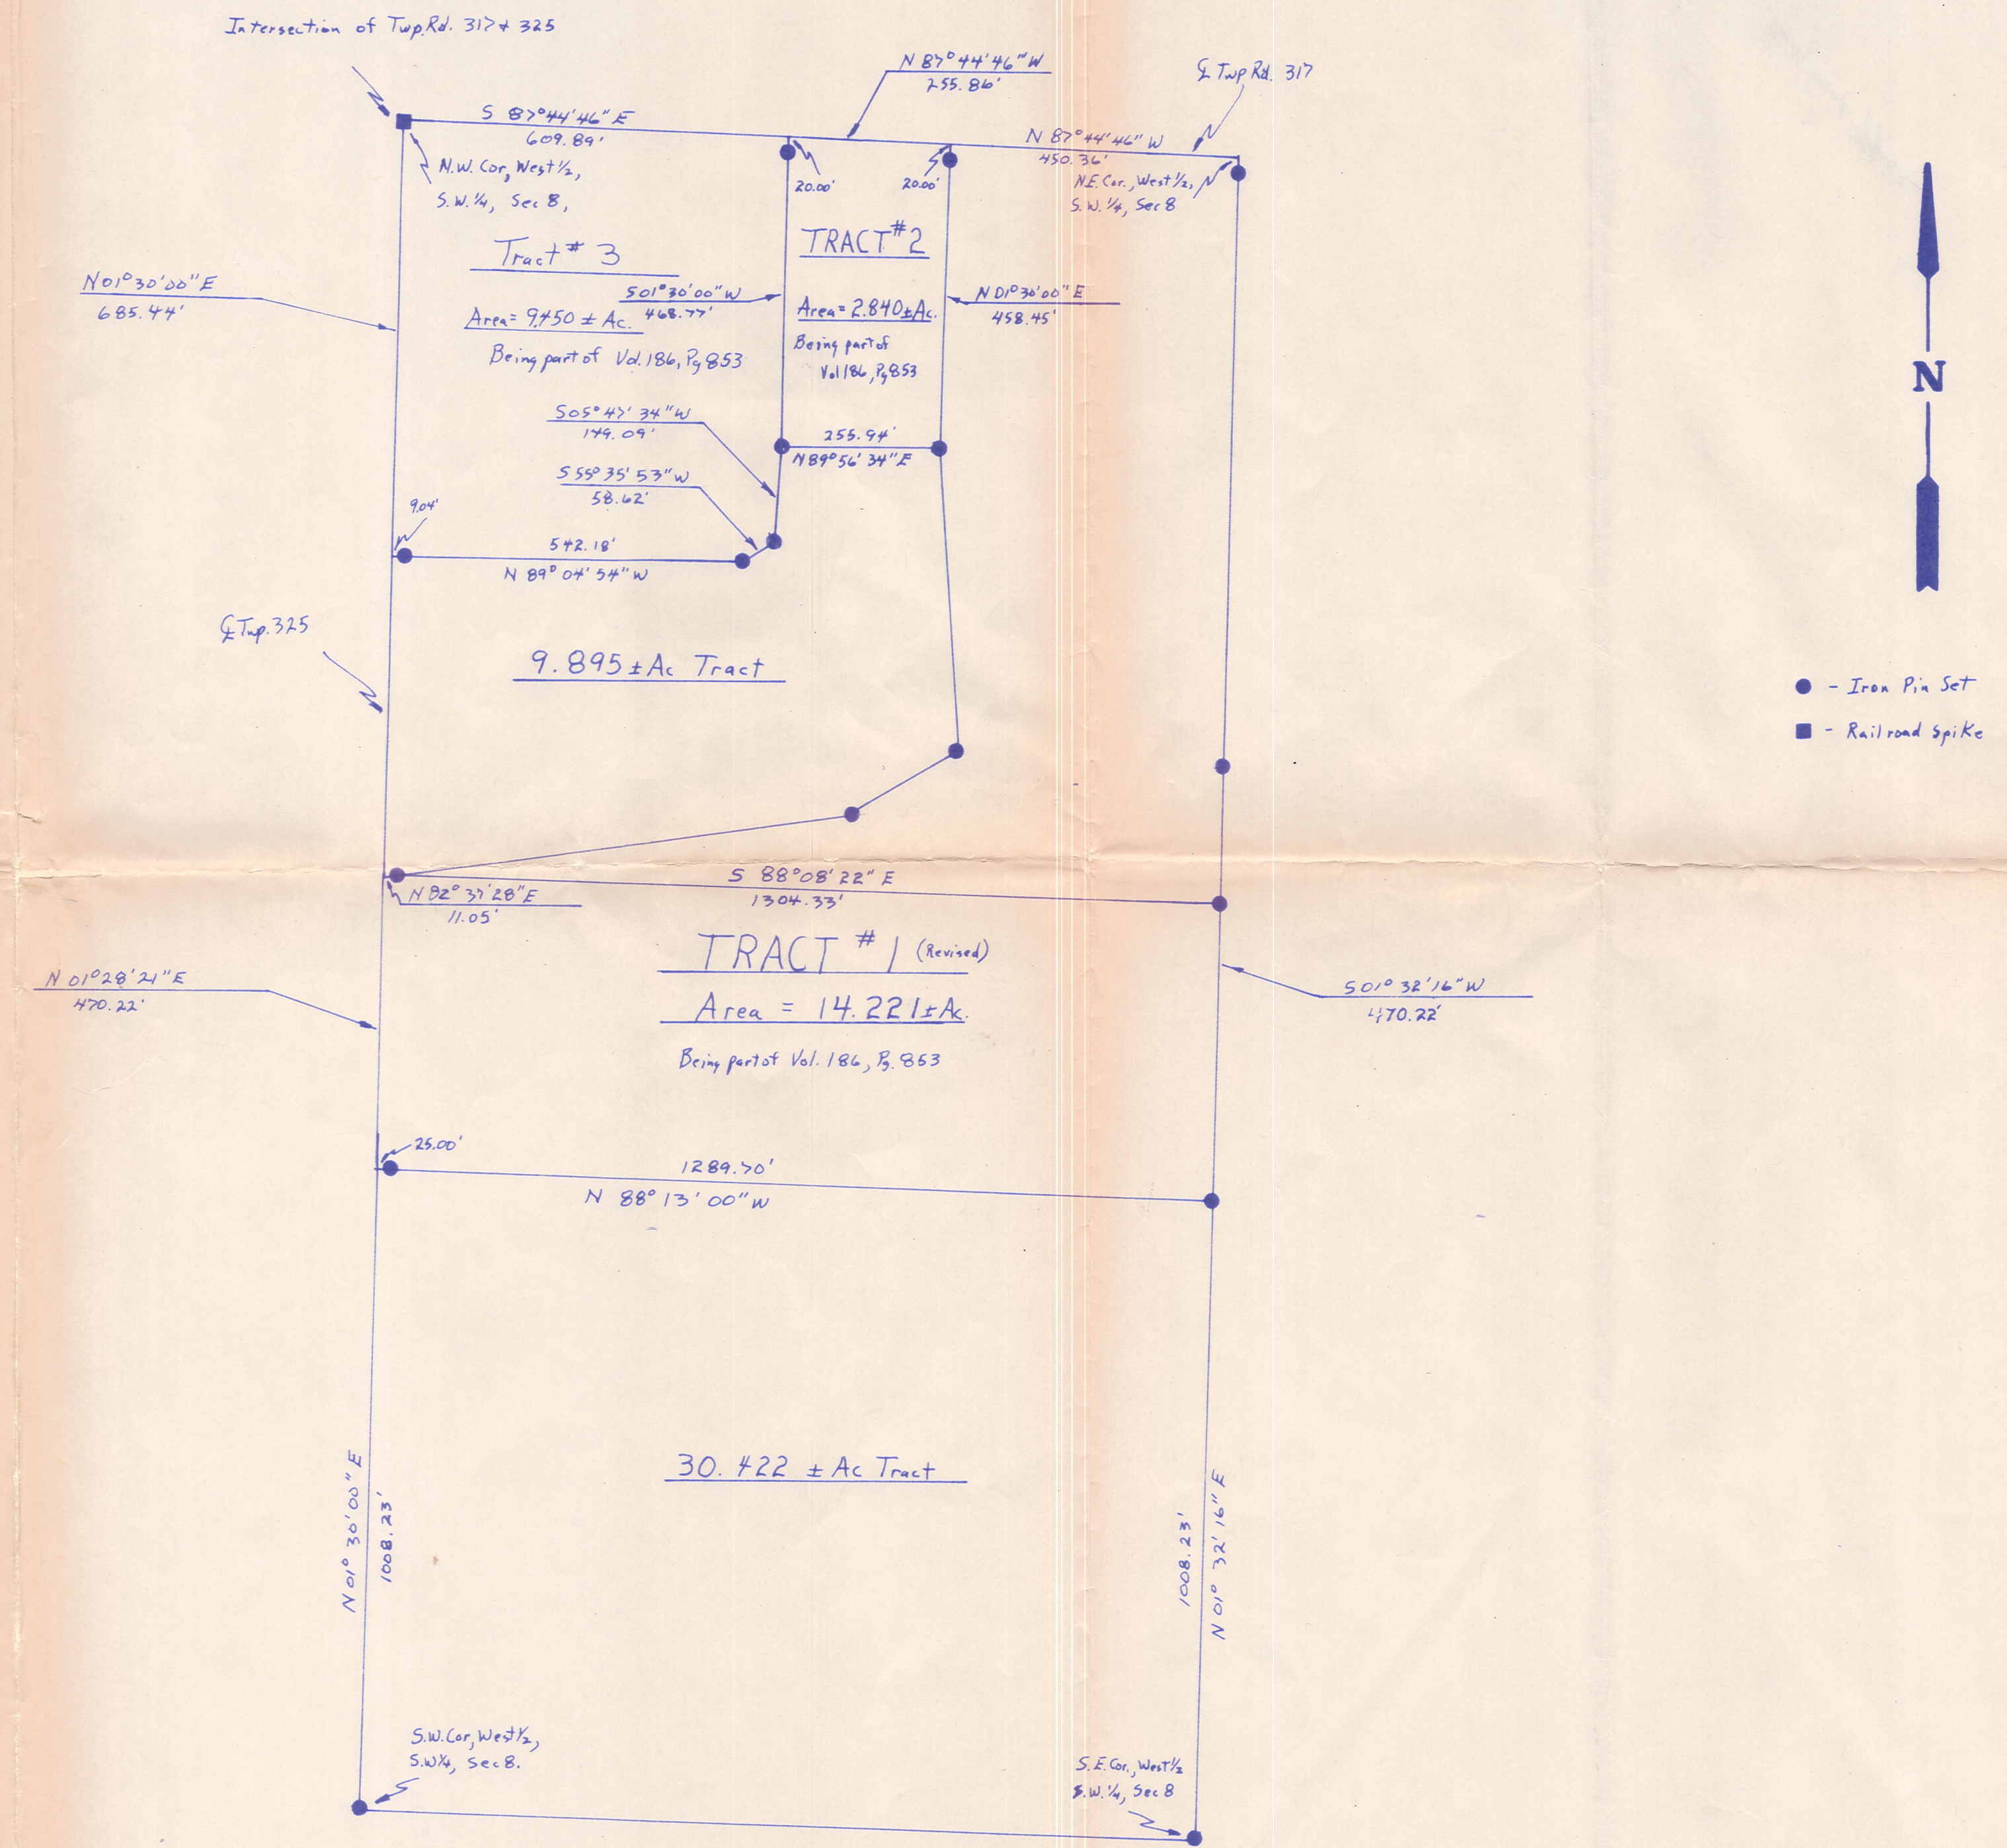

I HEREBY CERTIFY THE ABOVE PLAT TO BE CORRECT TO THE BEST OF MY KNOWLEDGE AND BELIEF.

James V. Gute
 REGISTERED SURVEYOR - 5935
 REGISTERED ENGINEER - 37405

