BEING PART OF: LOT ~
SEC. 8
QUAR. 2nd
T 17 N. R 14 W, Congress Lands North of the Old Seven Ranges
TWP. RIPLEY
COUNTY HOLMES

THE COSHOCTON LAND SURVEYING SERVICE

233 S. FOURTH ST. COSHOCTON, OHIO 43812
PHONE: 614-622-4545

SURVEY FOR: Luther Hathorn
DATE: Sept. 1974
SCALE: 1" = 200'

Tract #1 Revised Sept 1974

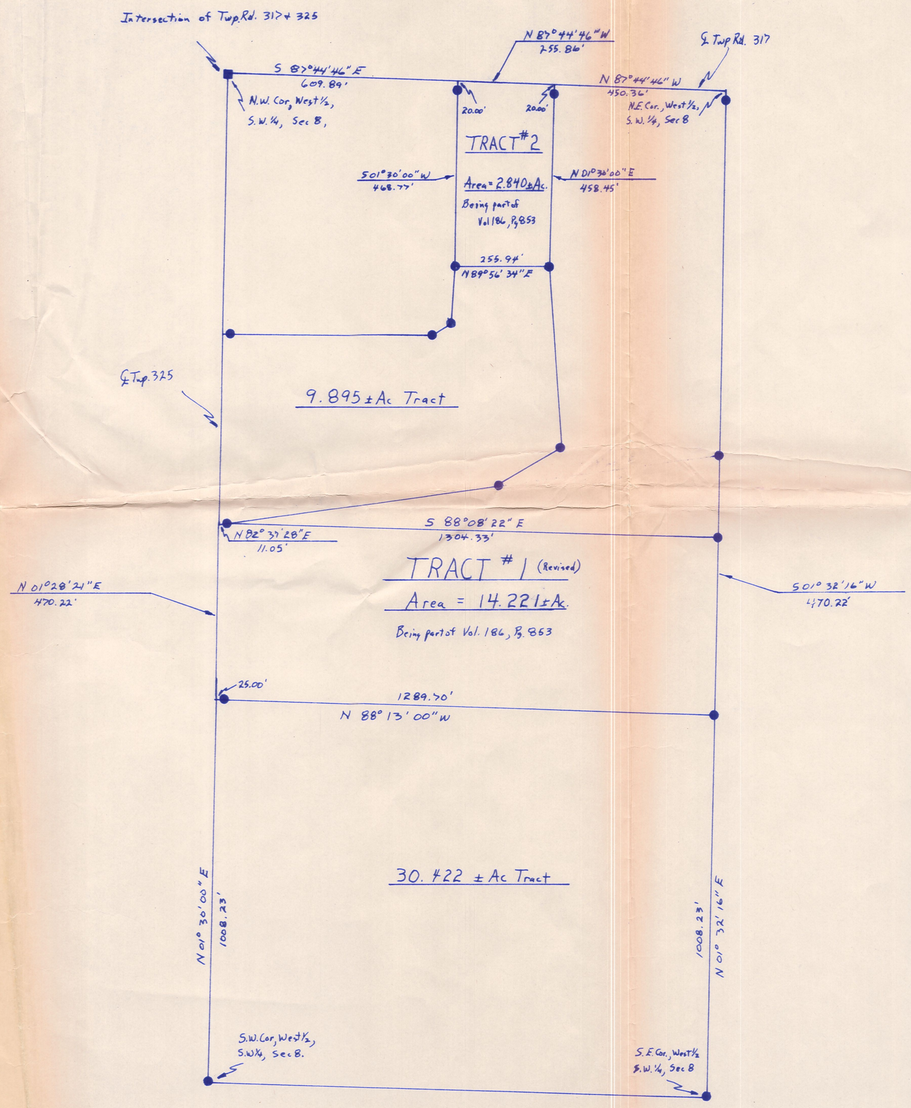

I HEREBY CERTIFY THE ABOVE PLAT TO BE CORRECT TO THE BEST OF MY KNOWLEDGE AND BELIEF.

REGISTERED SURVEYOR ~ 5835
REGISTERED ENGINEER ~ 37405

STATE OF OHIO
JAMES V. GUTE
5935
REGISTERED
SURVEYOR

STATE OF OHIO
JAMES V. GUTE
37405
REGISTERED
PROFESSIONAL ENGINEER