


BEARINGS ARE TO AN ASSUMED MERIDIAN AND ARE USED TO DENOTE ANGLES ONLY.


- LEGEND:
- = STONE FD.
 - = IRON PIN/PIPE FD.
 - = POINT-OF-DEPARTURE
 - = 5/8" X 30" RE-BAR W/PLASTIC I.D. CAP SET
 - ⊗ = R/R SPIKE SET
 - △ = R/R SPIKE FD.

REFERENCE DOCUMENTS:
 TAX MAPS
 DEEDS AS SHOWN
 SURVEY PLATS:
 5/77
 7/325

DAVID L. & SANDRA L. SCHLAUCH
 169/567

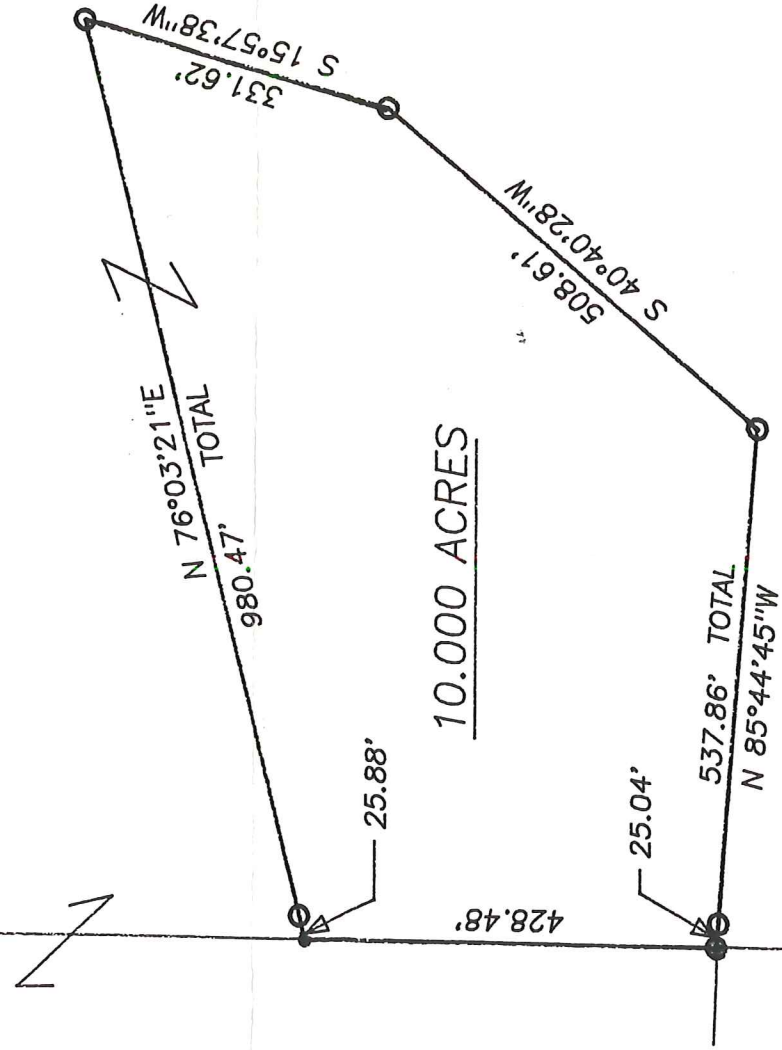

10.000 ACRES

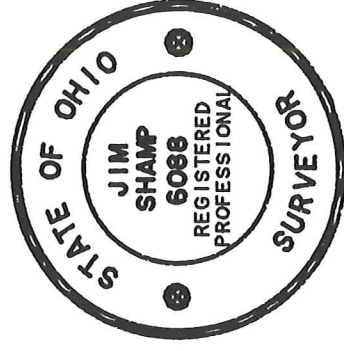

I CERTIFY THIS TO BE A TRUE PLAT OF A FIELD SURVEY COMPLETED ON MARCH 12, 1997:

J. Shamp

JIM SHAMP, REG. SUR. NO. S-6086

HEARTLAND Surveying, Inc.

5210 T.R. 257
 Jim Shamp
 MILLERSBURG, OH 44654
 PH: 330-674-4698

SURVEY		LUKE REYNOLDS		DATE	
				MARCH 26, 1997	
STATE	OHIO	COUNTY	HOLMES	TWP.	RIPLEY
TWP.	17 N				RNG. 14 W
			N.E. QUARTER	SECTION 17	
				2/97	970316

