R I P L E Y T O W N S H I P
SECTION 26 SE QUARTER
TWP 18 RANGE 14
WOLMES COUNTY OHIO

made for
Mr Allen Jarvis

389

A - Iron Pipe found
Tele Pole NW 32 ft
15" Elm NW 39.5 ft

B - Iron Pin found
Tele Pole NW 44.7 ft
Elec Pole SE 17.5 ft
15" Silver Maple SW 102 ft

C - Iron Pin found
20" Shellbark Hickory NW 42 ft
30" B Oak N 130.5 ft

D - Iron Pipe set
10" Elm W 3 ft

E - Iron Bolt set in road
Tele Pole SW 56.7 ft

O - Iron Corners found
● - Iron Corners set

I certify this survey to be correct to the best of my knowledge.

Completed December 1958

Ray W Gasbarre
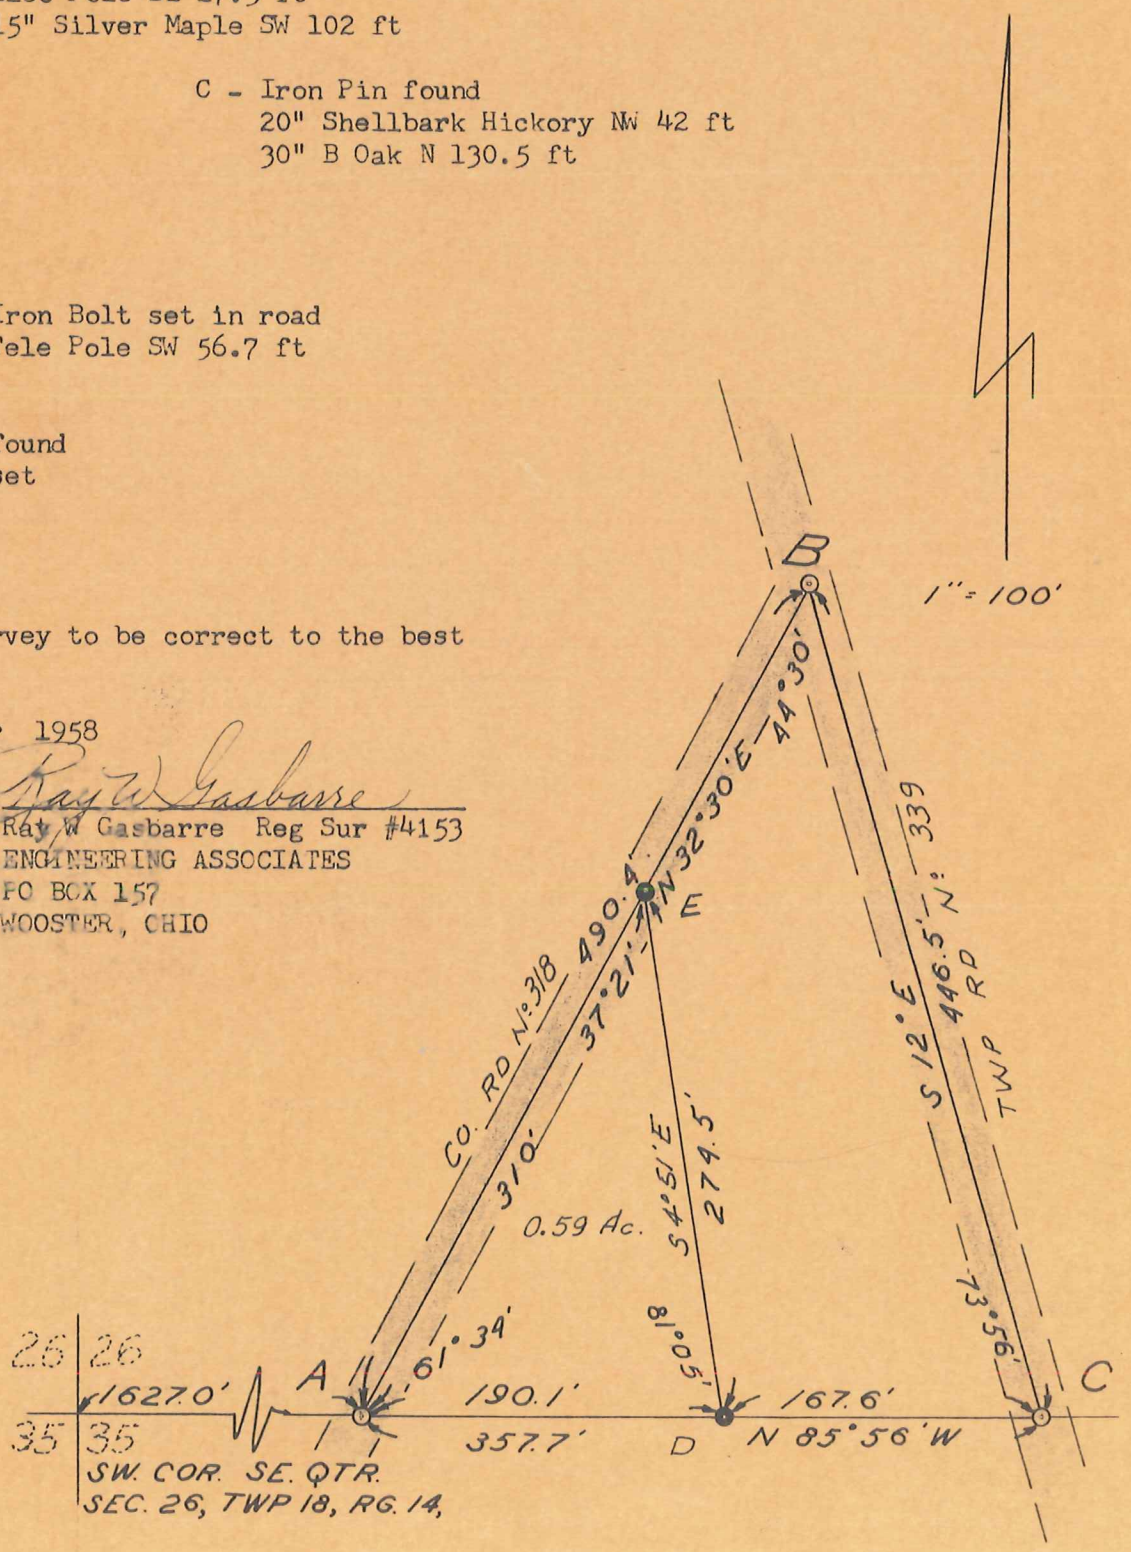
Ray W Gasbarre Reg Sur #4153
ENGINEERING ASSOCIATES
PO BOX 157
WOOSTER, OHIO