


RIPLEY TOWNSHIP
 N.E. QTR. SECTION 26
 T-18N; R-14W
 HOLMES COUNTY, OHIO



SCALE: 1" = 200'

- IRON PIN FOUND
- △ R.R. SPIKE SET
- P.K. NAIL SET
- 5/8" RE BAR WITH I.D. CAP SET
- I.D. CAP MARKED "BAKER 6938"

BEARINGS ASSUMED

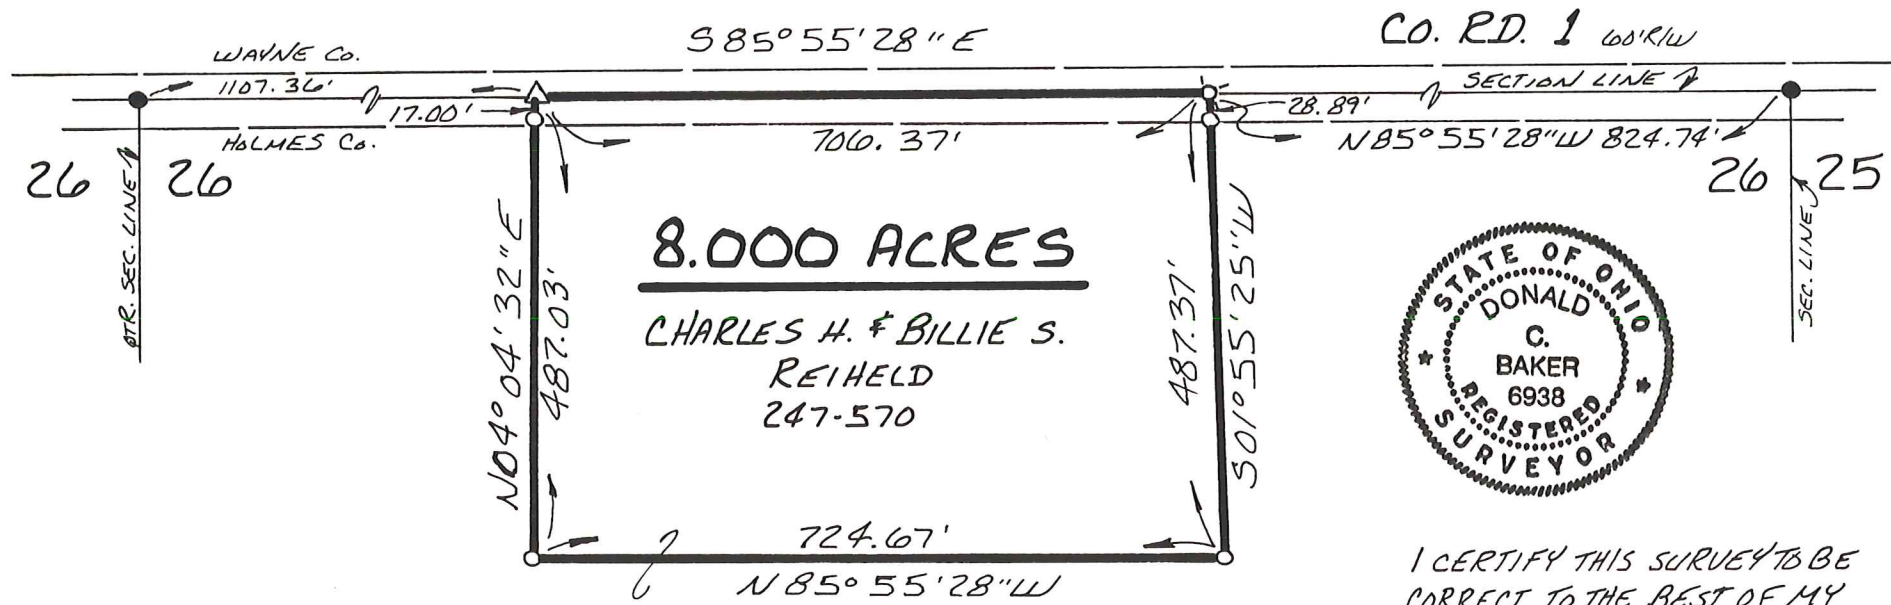

I CERTIFY THIS SURVEY TO BE
 CORRECT TO THE BEST OF MY
 KNOWLEDGE.

Donald C. Baker
 DONALD C. BAKER P.S. 6938
 5958 T.P. 322
 MILLERSBURG, OHIO 44654
 PH. (216) 674-4788

MAY 8, 1992