

A survey of the S. part of Inlot No. 17 in the Village of Big Prairie, Holmes County Ohio. December 1953 See Survey of August 25, 1949 for previous layout


- A. Iron pipes found
- B. Iron pipes set on E. line of Lot 17 set under ^a eyes of Fulmer house
- C. X found cut in sidewalk - S.W. corner of Lot 17

I certify this survey to be correct to the best of my knowledge and belief.

T. 18 R. 14 SEC. 30

RIPLEY

[Signature]
 J. T. McClure
 2403

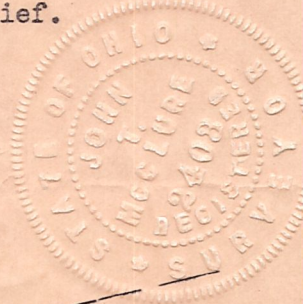

N
 1 IN. = 20 FT.

