


No 17

RIDLEY


T. 18 R. 14 SEC. 30
14

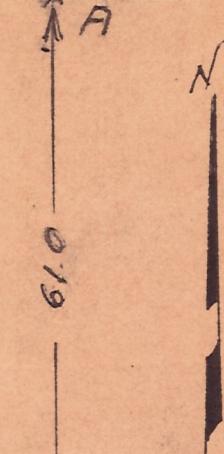

WAYNE ST. 60

389

1/1 N. = 20 FT.

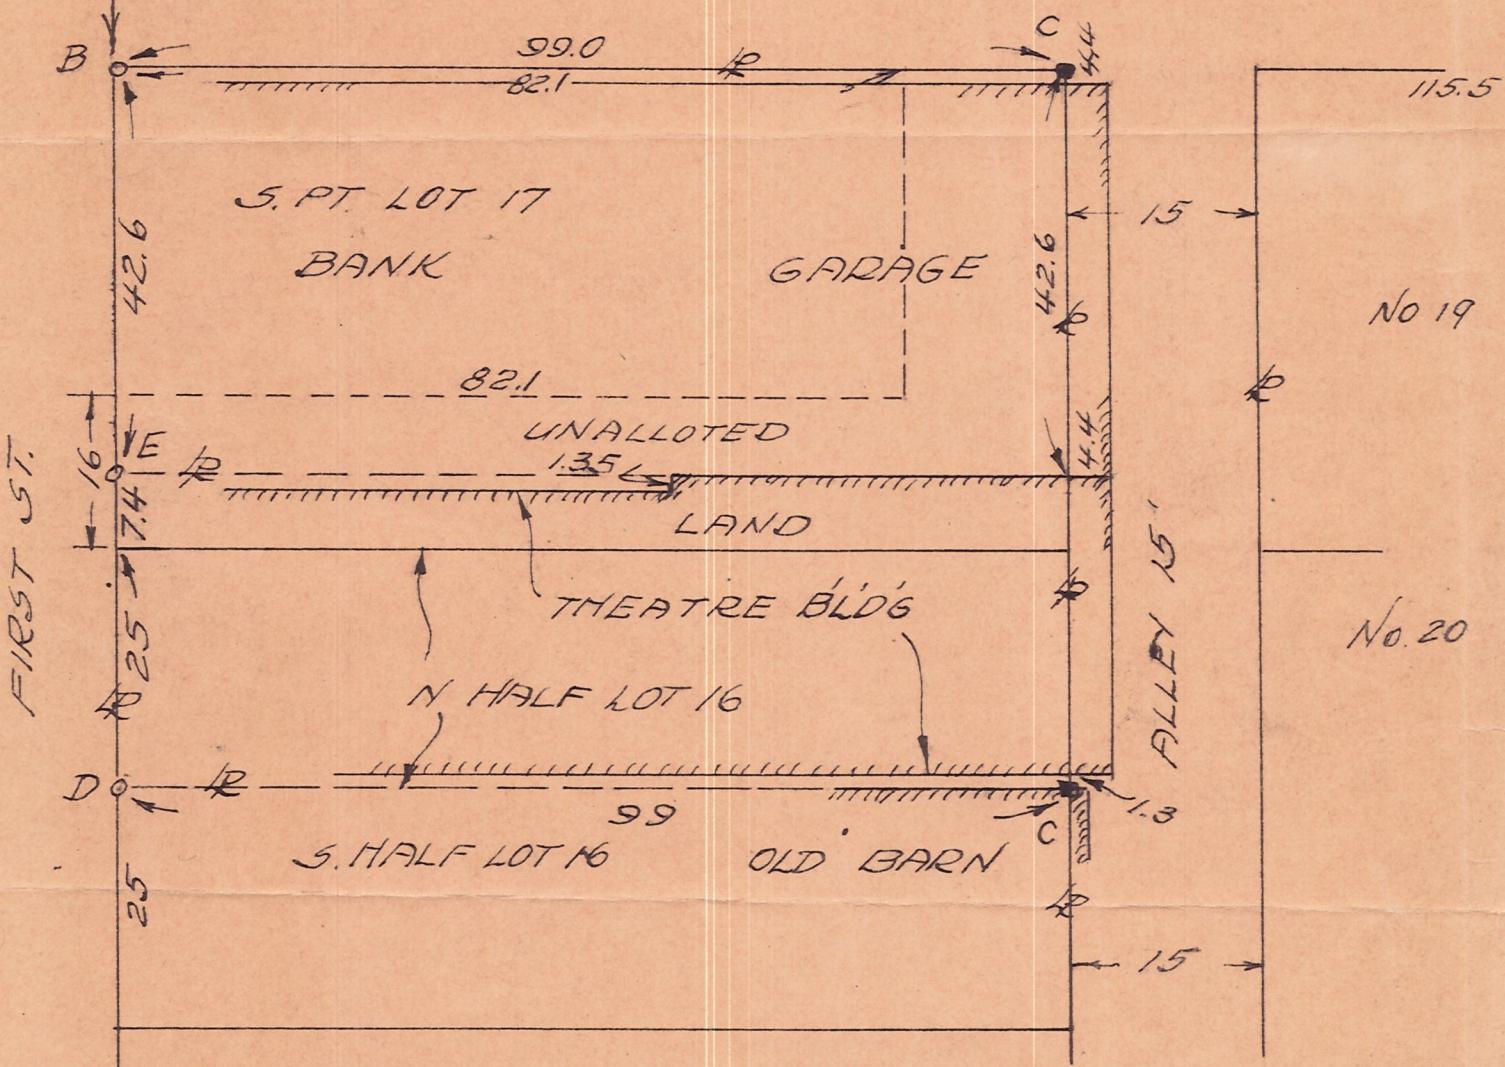

A survey of part of Lot 17 and the N. part of lot 16 and unallotted land between in the Village of Big Prairie, Holmes County Ohio. June 1955

- A. X found cut in side walk
- B. Hole found drilled in side walk
- C. Square top iron pipes set
- D. Hole drilled in top of concrete wall
- E. Iron pipe set on farthest north line of present Theatre building

I certify this survey to be correct to the best of my knowledge and belief.

J. T. McClure
2403