


HALL-KICK SURVEY  
 N.E. QTR. SEC. 30  
 TWP. 18 RANGE 14  
 RIPLEY TOWNSHIP  
 HOLMES COUNTY, O.  
 JANUARY 31, 1970

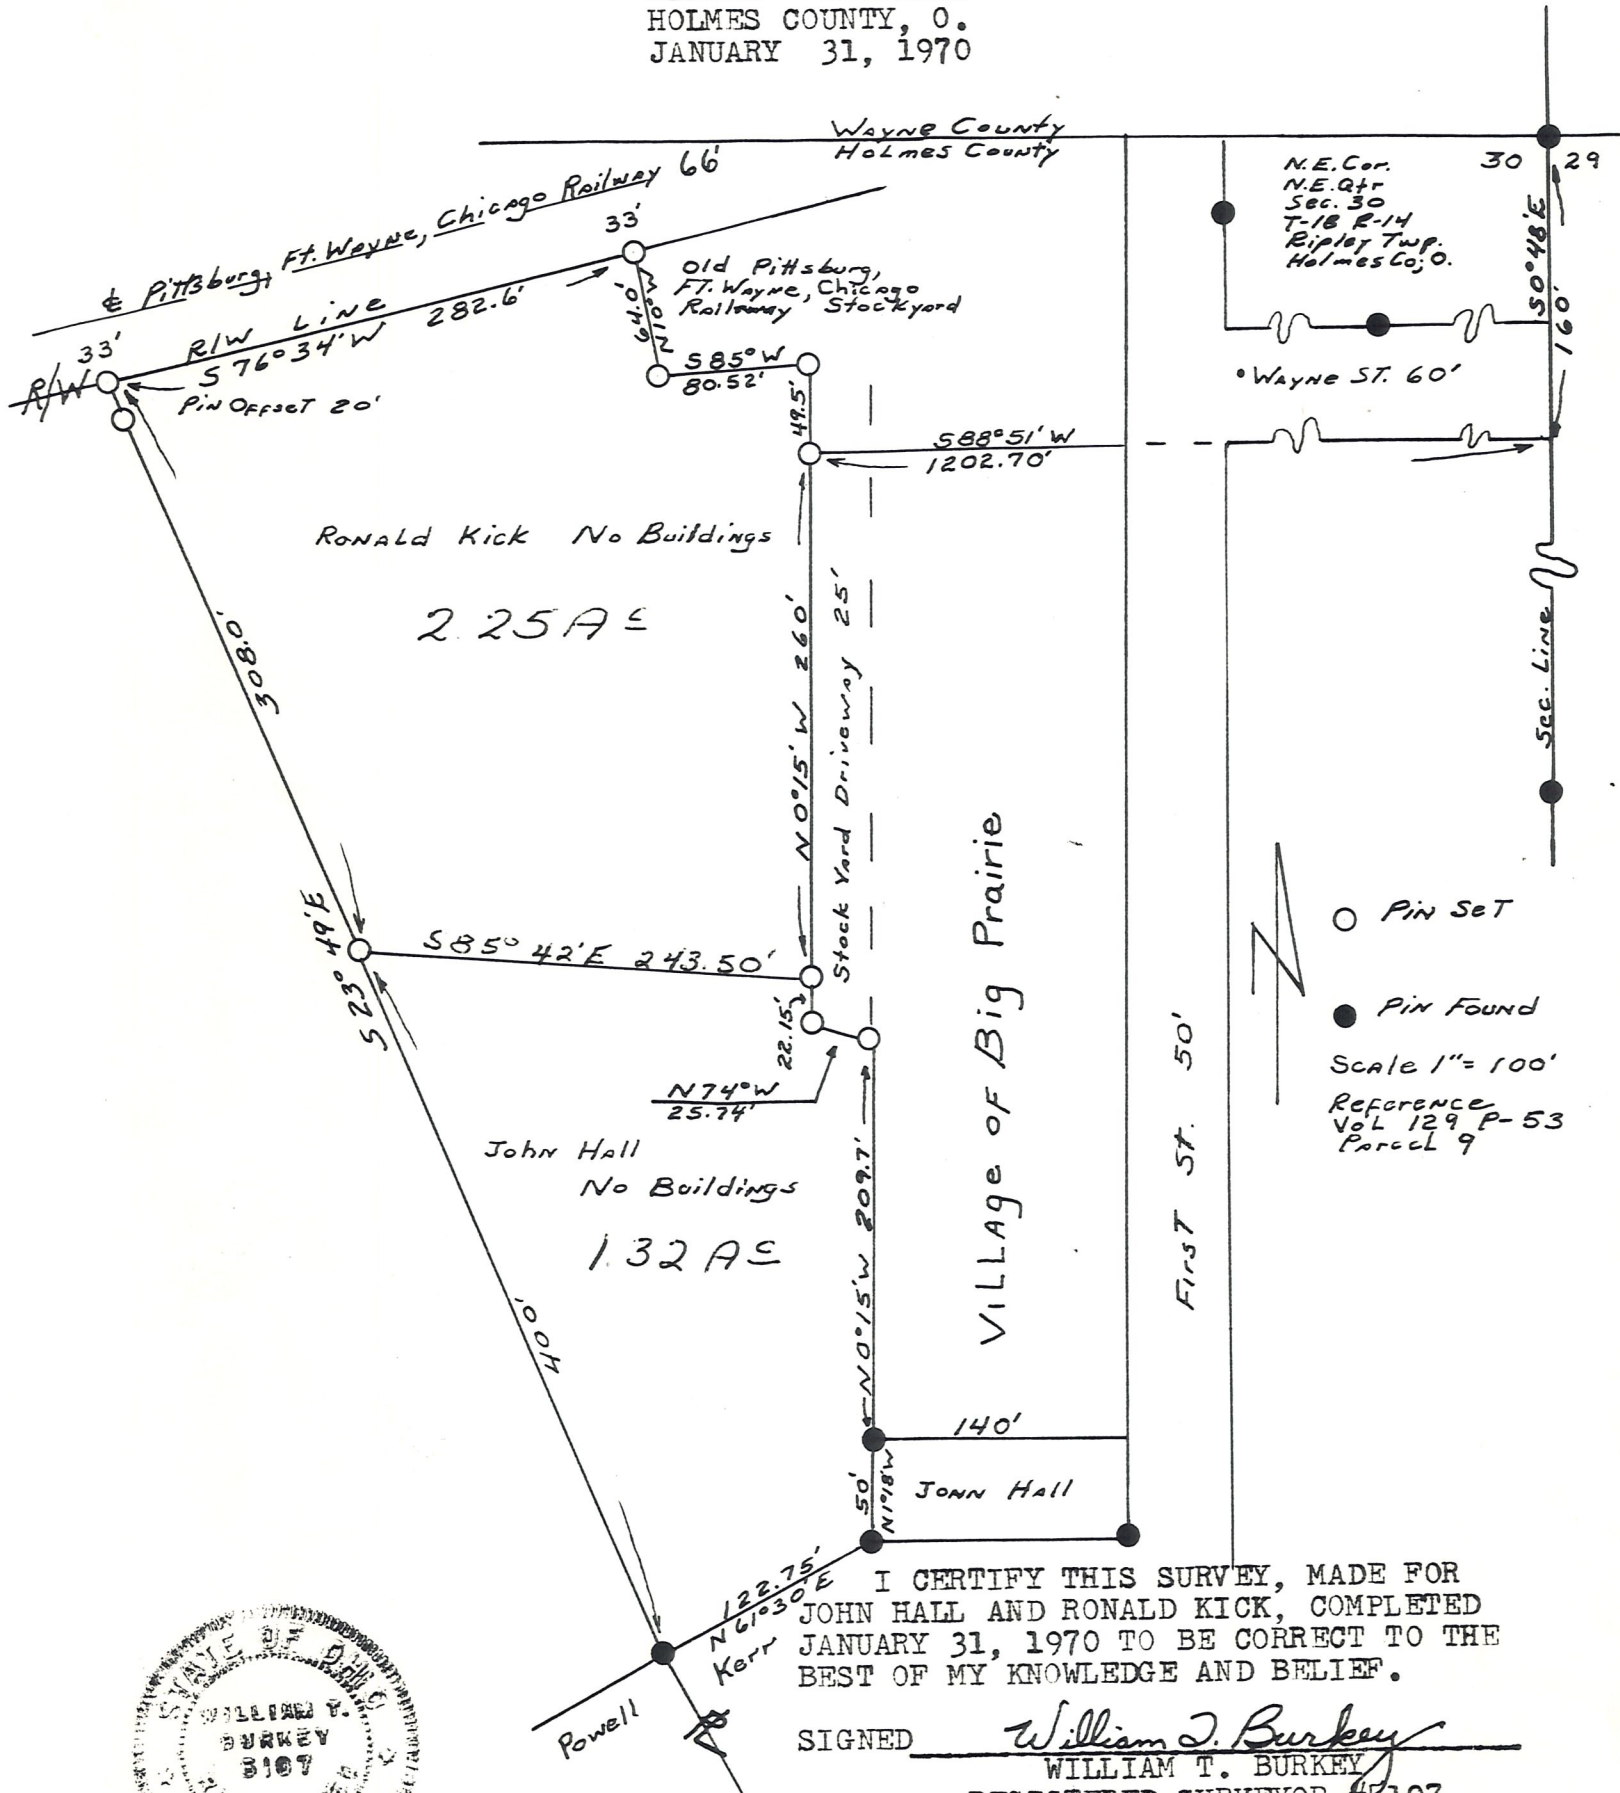

I CERTIFY THIS SURVEY, MADE FOR JOHN HALL AND RONALD KICK, COMPLETED JANUARY 31, 1970 TO BE CORRECT TO THE BEST OF MY KNOWLEDGE AND BELIEF.

SIGNED William J. Burkey  
 WILLIAM T. BURKEY  
 REGISTERED SURVEYOR #5107  
 STATE OF OHIO

