


R-14 TWP. 18 SEC. 30


VILLAGE OF BIG PRAIRIE, HOLMES COUNTY, OHIO
PART OF LOTS 17 & 67

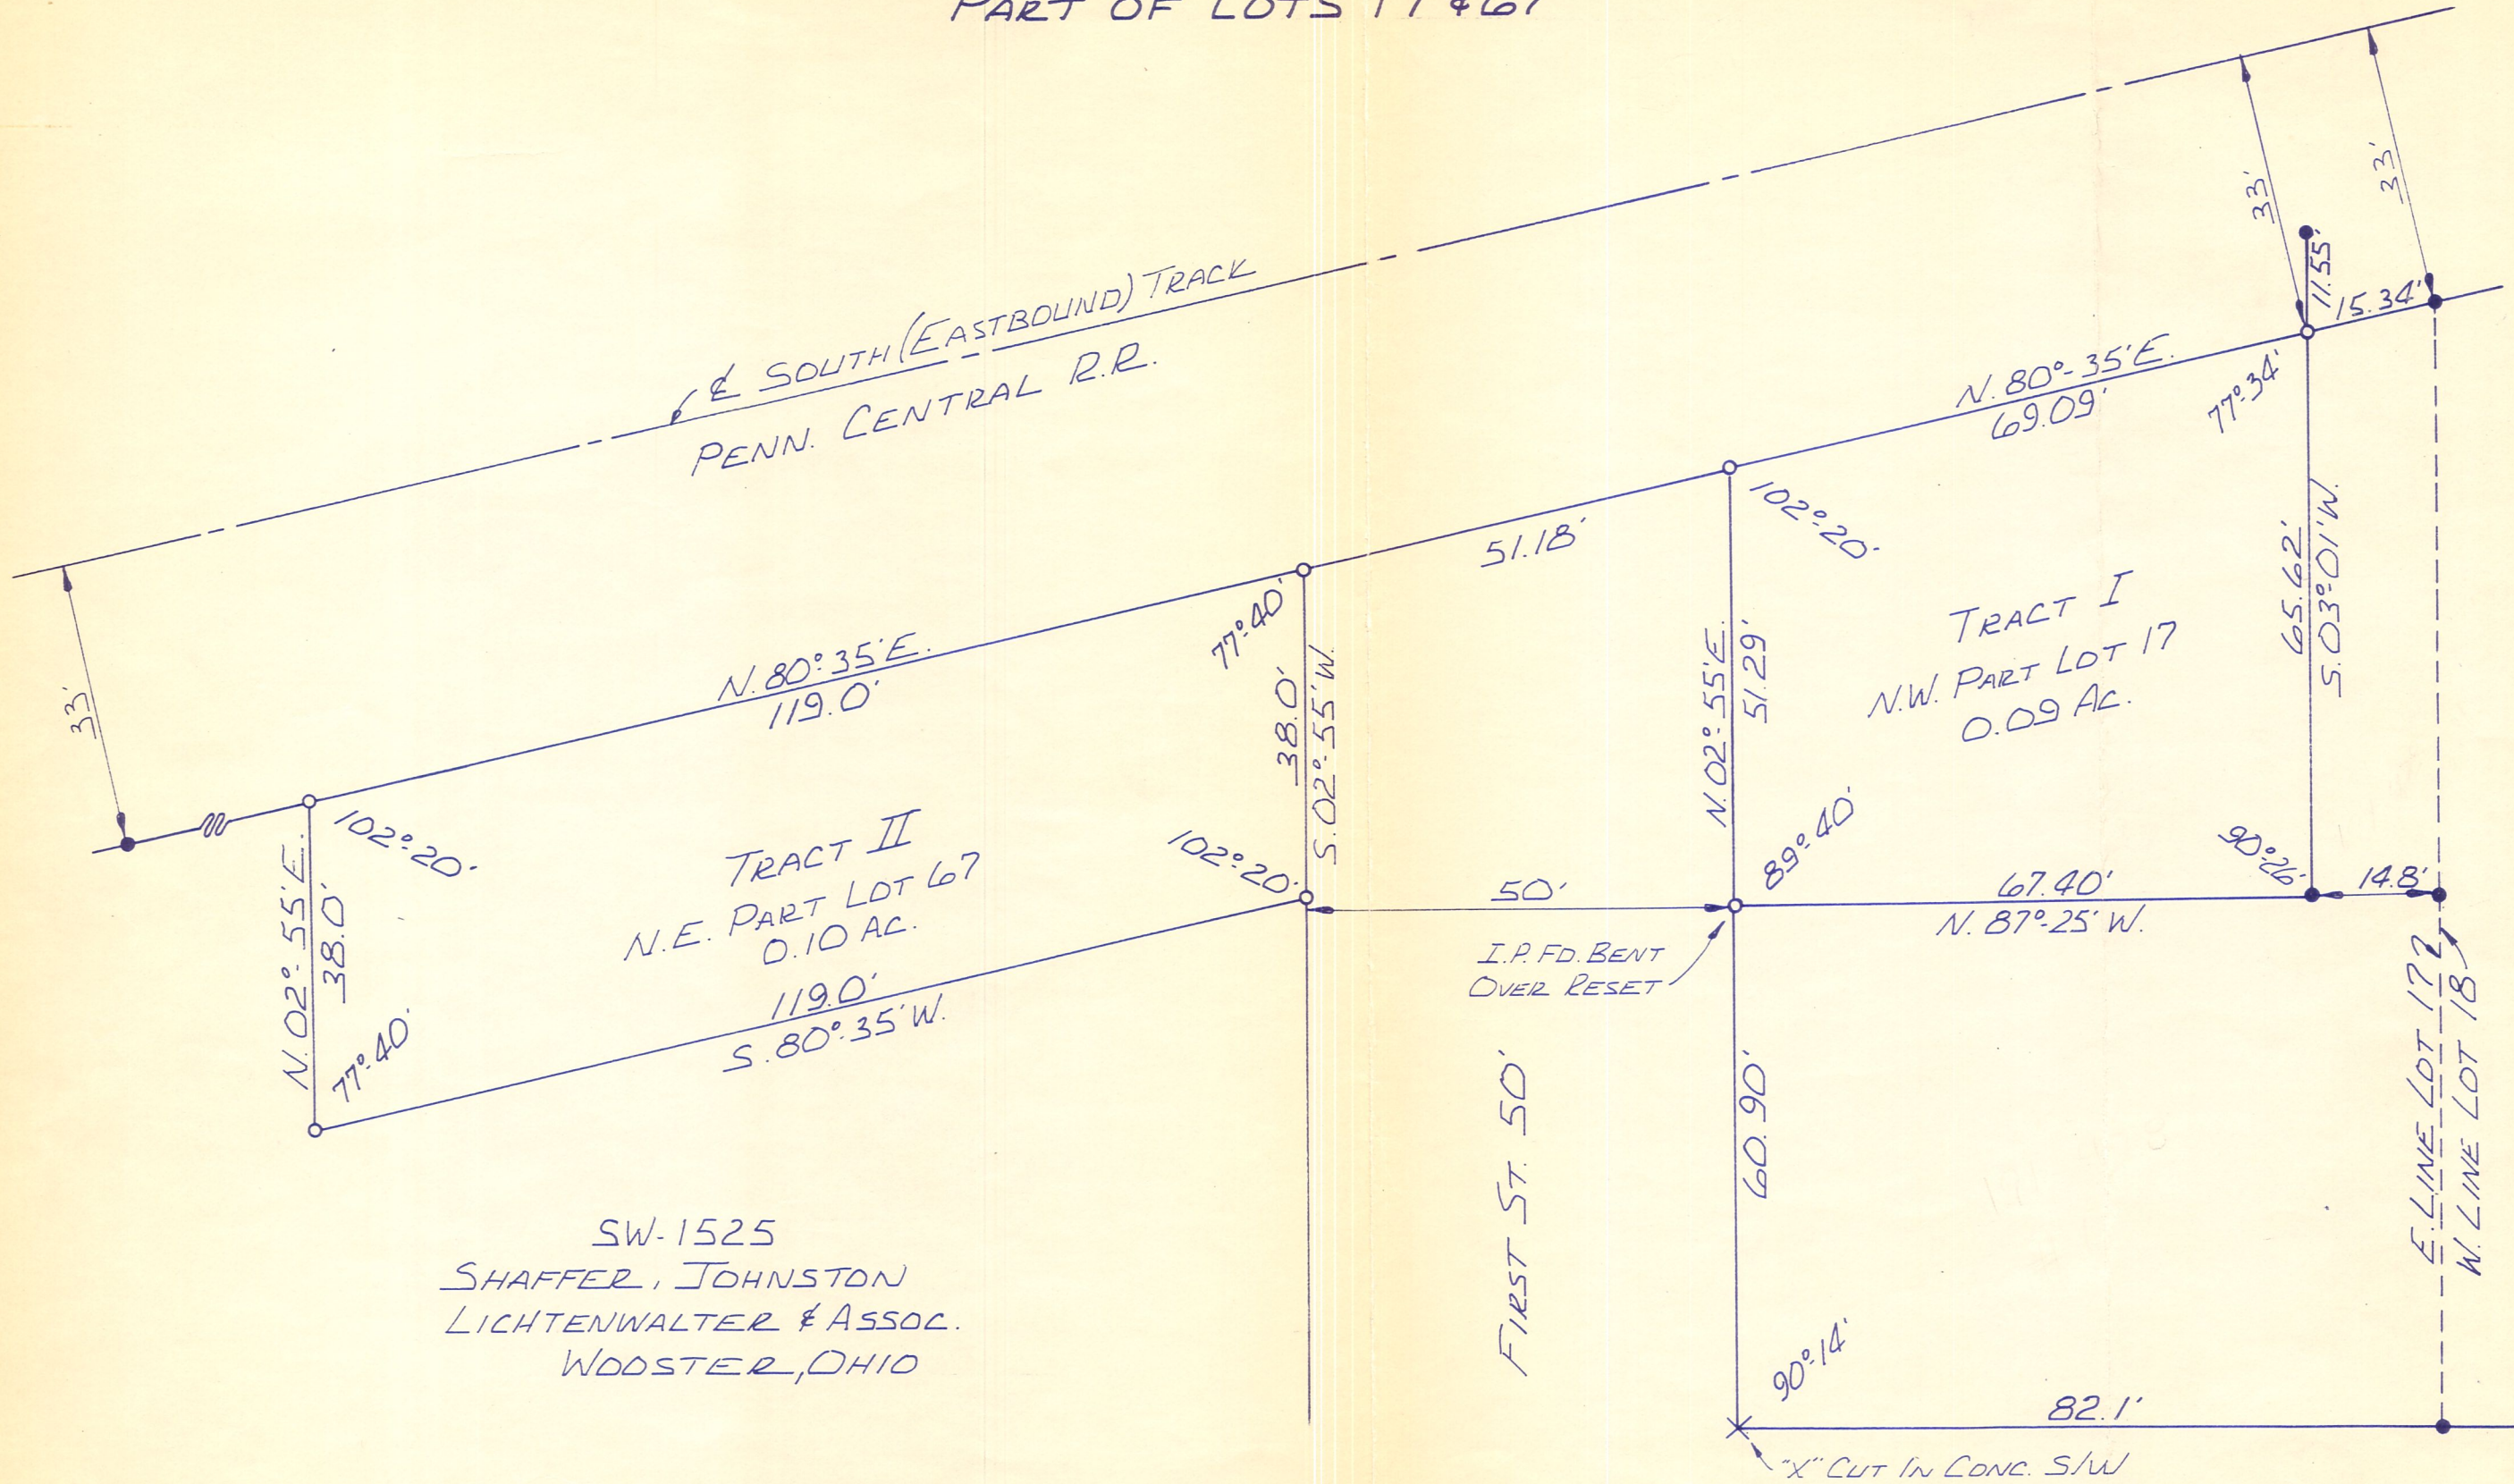

SW-1525
SHAFFER, JOHNSTON
LICHTENWALTER & ASSOC.
WOOSTER, OHIO

I CERTIFY THIS SURVEY AND PLAT
TO BE CORRECT TO THE BEST OF
MY KNOWLEDGE, JAN. 2, 1973

Richard J. McDaid
RICHARD J. MCDAID P.S. 5009

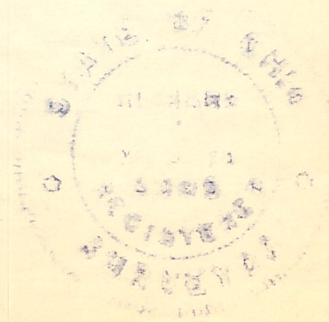

WAYNE ST. 60'