

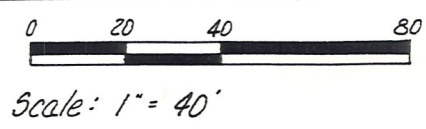


PT. LOT 18 VILLAGE OF BIG PRAIRIE
 RIPLEY TOWNSHIP, HOLMES COUNTY, OHIO
 SECTION 30, T-18N, R-14W

€
 CLINTON TOWNSHIP, WAYNE COUNTY, OHIO
 SE QTR. SECTION 19, T-18N, R-14W

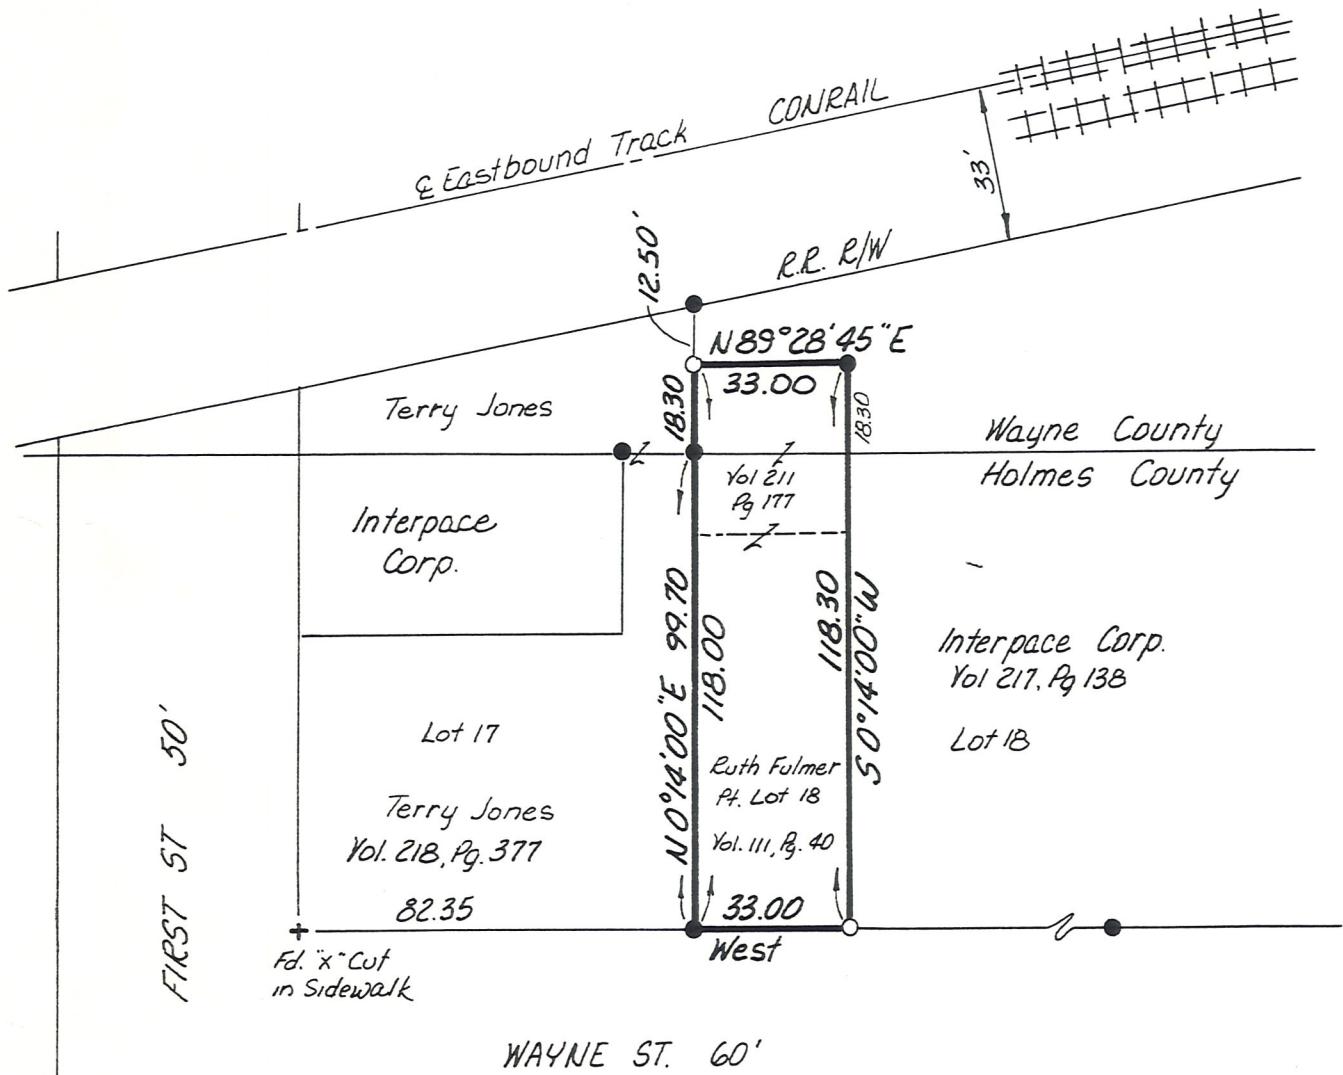

I Certify This Plat To Be Correct To The
 Best Of My Knowledge.
 William H Long
 William H Long R.S. 6505 November 12, 1982
 RD#1 Box 69A
 Big Prairie, Ohio 44611

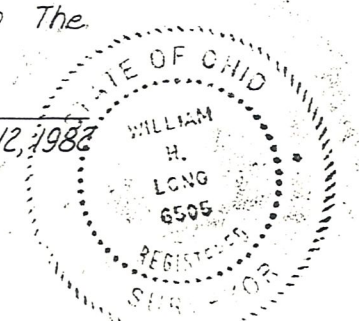

- Iron Pin Found
- Iron Pin Set - 5/8" Rebar w/ Cap. Marked "LONG-6505"