RETRACEMENT SURVEY OF
OFFICIAL RECORD VOL. 65 PAGE 56

0 50 100

SCALE: 1"=50'

● 5/8" REBAR FOUND
UNLESS OTHERWISE NOTED

○ 5/8" REBAR WITH I.D. CAP SET
I.D. CAP MARKED "BAKER 6938"

REFERENCES

DEED VOL. 229 PAGE 254
O.R. VOL. 65 PAGE 56
O.R. VOL. 168 PAGE 3029
PLAT VOL. 19 PAGE 248

BEARINGS FROM PLAT VOL. 19 PAGE 248

LAKELAND BEACH SUBDIVISION
(PLAT VOL. 1 PAGES 379 & 380)
PART OF OUTLOT 4

RIPLEY TOWNSHIP
N.W. QTR. SECTION 30
T-18 N; R-14 W
HOLMES COUNTY, OHIO

SURVEYED FOR: JANE CARMICHAEL

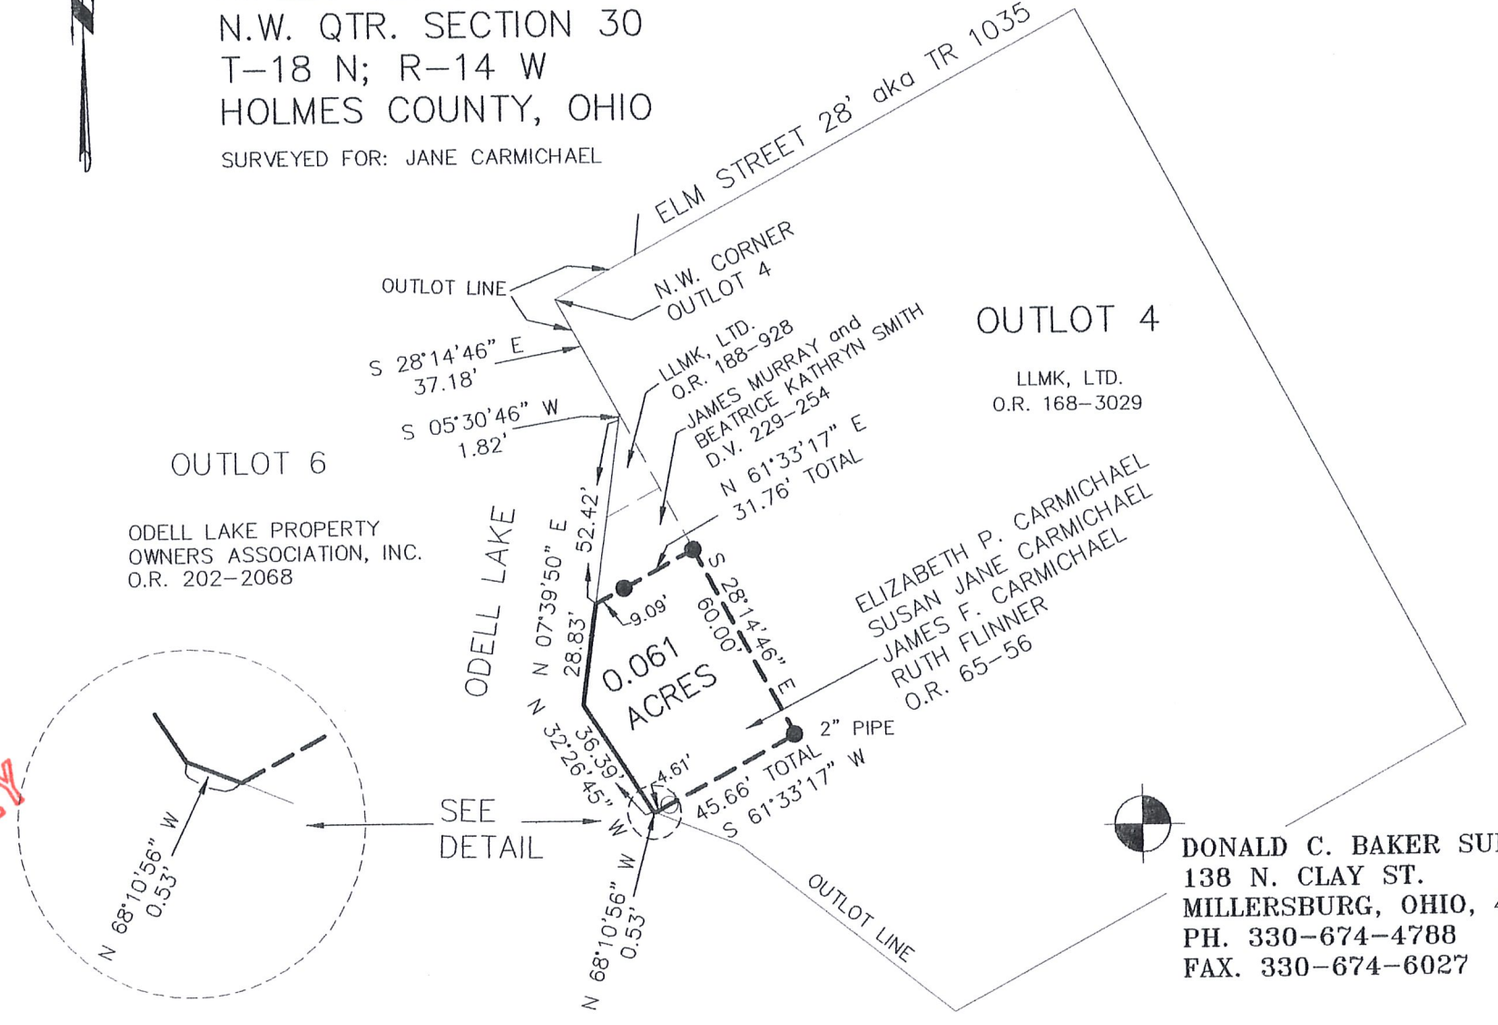

I CERTIFY THIS SURVEY TO BE CORRECT
TO THE BEST OF MY KNOWLEDGE.

DONALD C. BAKER P.S. 6938
DATE: JULY 31, 2008
KES\ERZ
File Name: WORK2\S-361-08\MLD

PRELIMINARY
FOR REVIEW ONLY

DONALD C. BAKER SURVEYING
138 N. CLAY ST.
MILLERSBURG, OHIO, 44654
PH. 330-674-4788
FAX. 330-674-6027