


RIPLEY TOWNSHIP
 S.W. QTR. SECTION 36
 T-18N; R-14W
 HOLMES COUNTY, OHIO



REFERENCES:

- DEED VOL. 225 PAGE 74
- DEED VOL. 233 PAGE 901
- DEED VOL. 166 PAGE 374
- DEED VOL. 232 PAGE 748
- DEED VOL. 221 PAGE 451
- DEED VOL. 222 PAGE 818

BEARINGS FROM DEED VOL. 222 PAGE 816

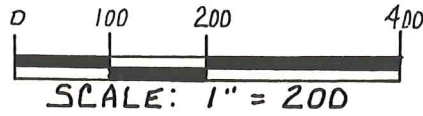

- IRON PIN FOUND
- 5/8" REBAR WITH ID. CAP SET
ID. CAP MARKED "BAKER 6938"

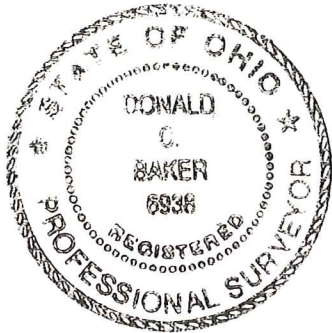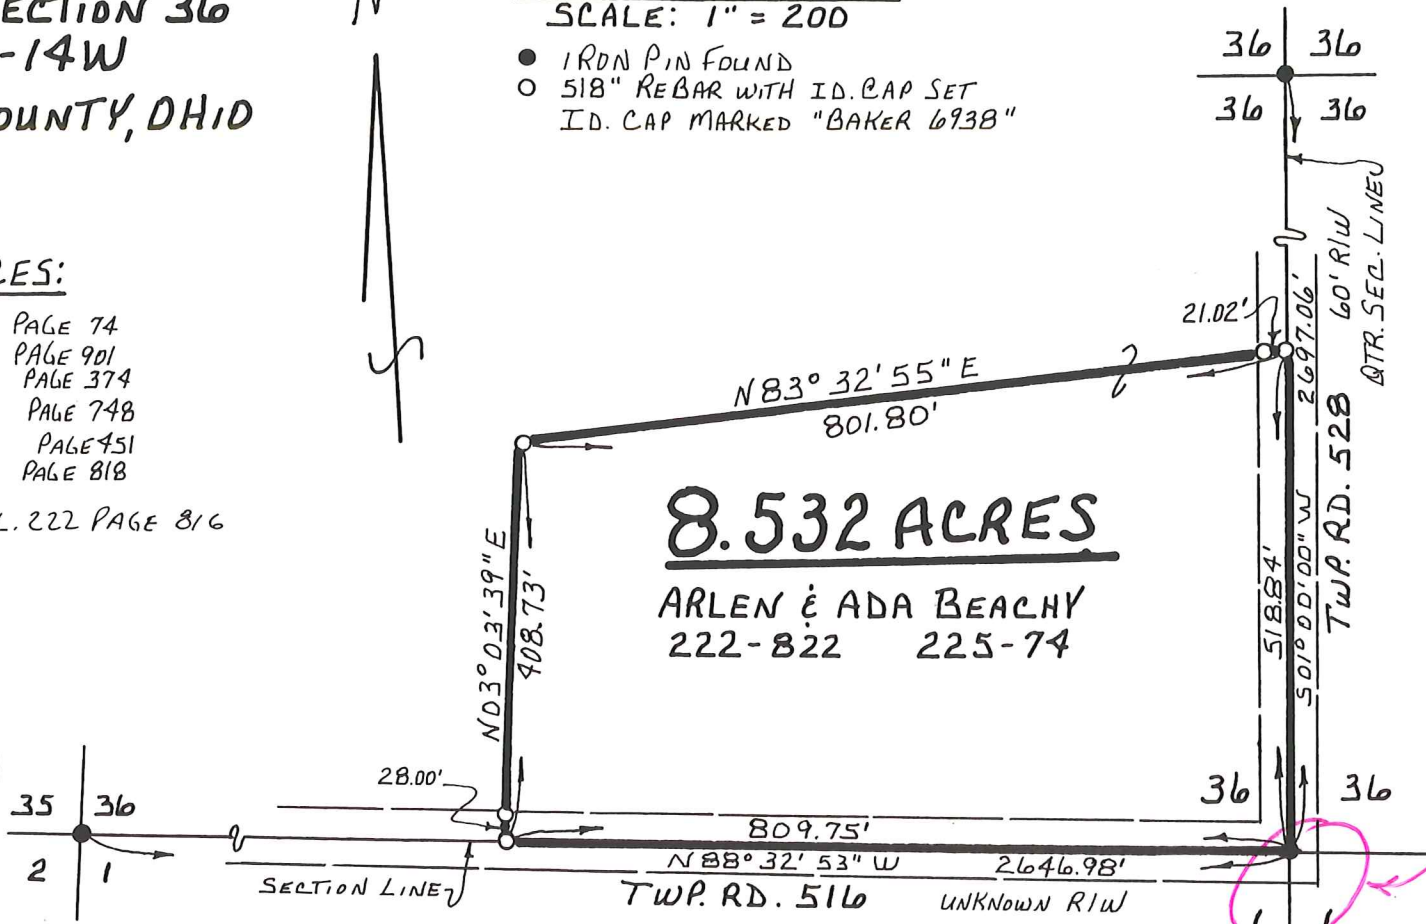

I CERTIFY THIS SURVEY TO BE CORRECT
 TO THE BEST OF MY KNOWLEDGE.

Donald C. Baker

DONALD C. BAKER P.S. 6938

5958 T.R. 322

MILLERSBURG, OHIO 44654

PH. (330) 674-4788

MAY 30, 1996

31396-SRU

road does not stop here, it continues east