


375

Not Posted

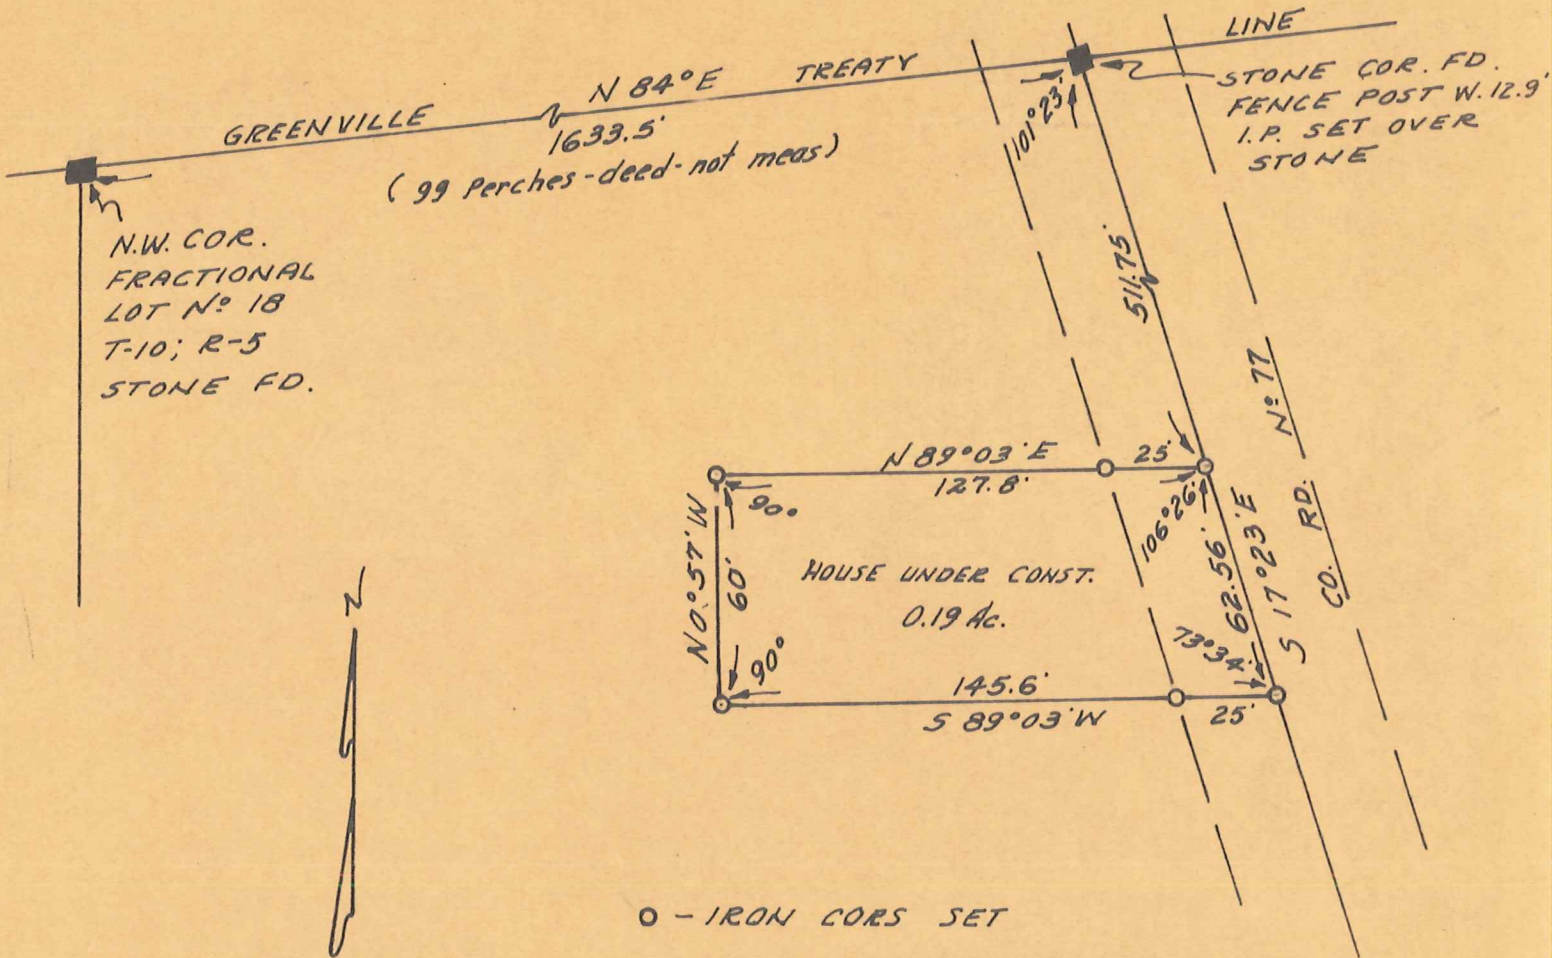

SCALE 1" = 50'

I certify this survey to be correct to the best of my knowledge.
Completed April 1959

Ray W. Gasbarre

Ray W Gasbarre Reg Sur #4153

ENGINEERING ASSOCIATES

PO BOX 157

WOOSTER, OHIO